



Datum 30.00

Front Elevation - East  
Broughton House

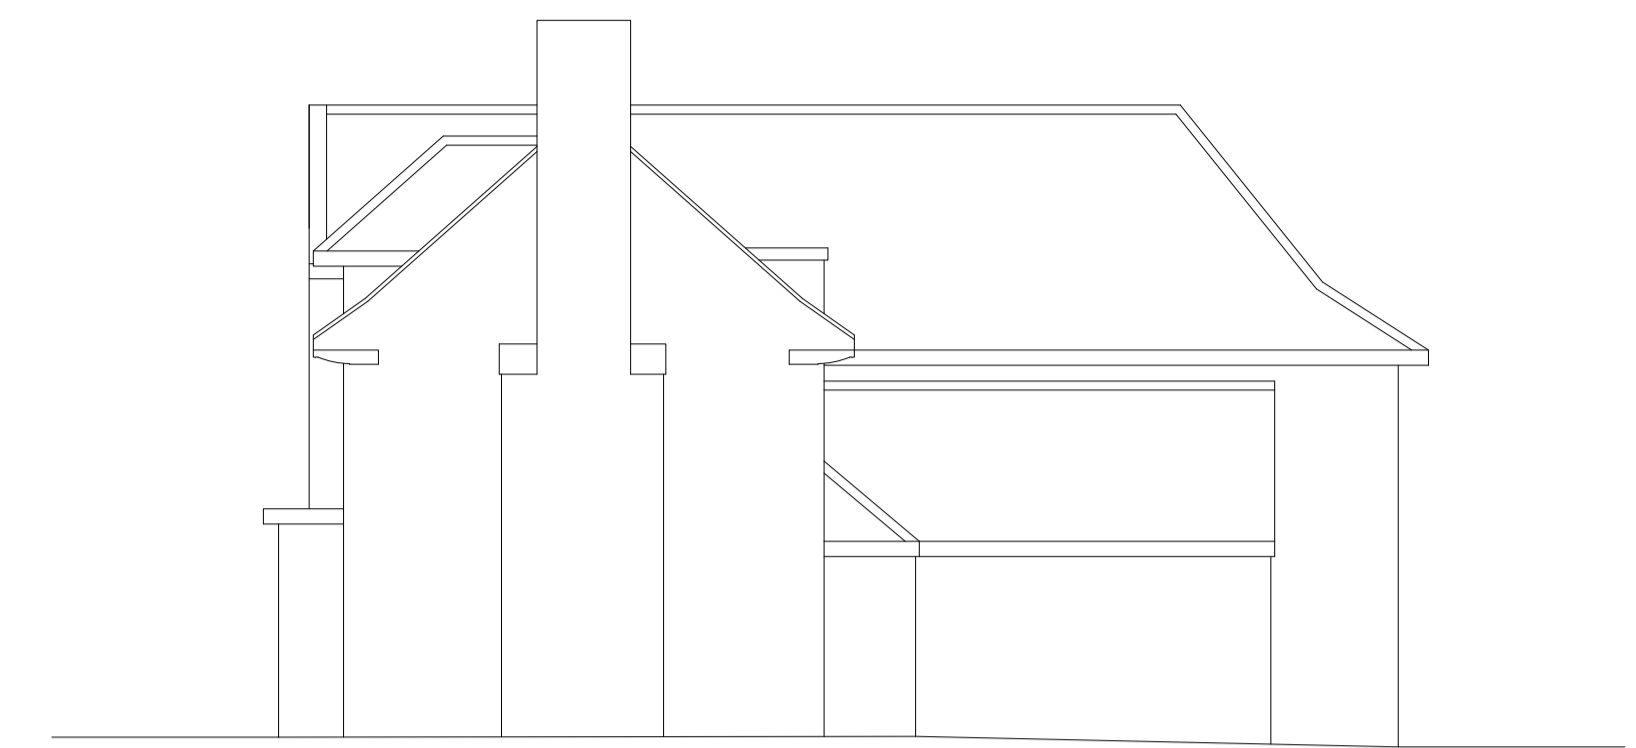


Datum 30.00

Side Elevation - North  
Broughton House

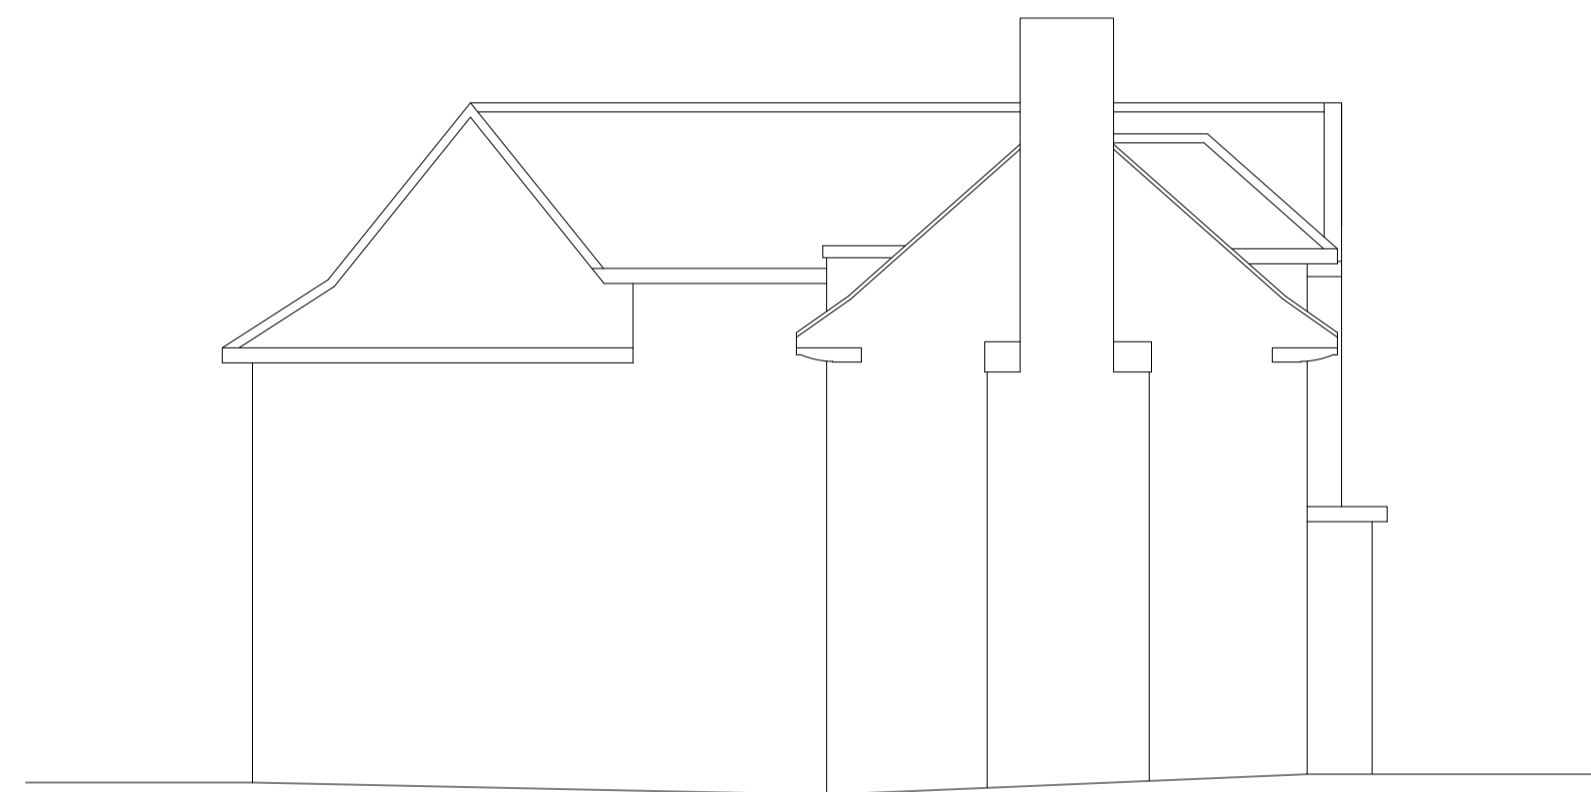


Datum 30.00

Side Elevation - South  
Broughton House

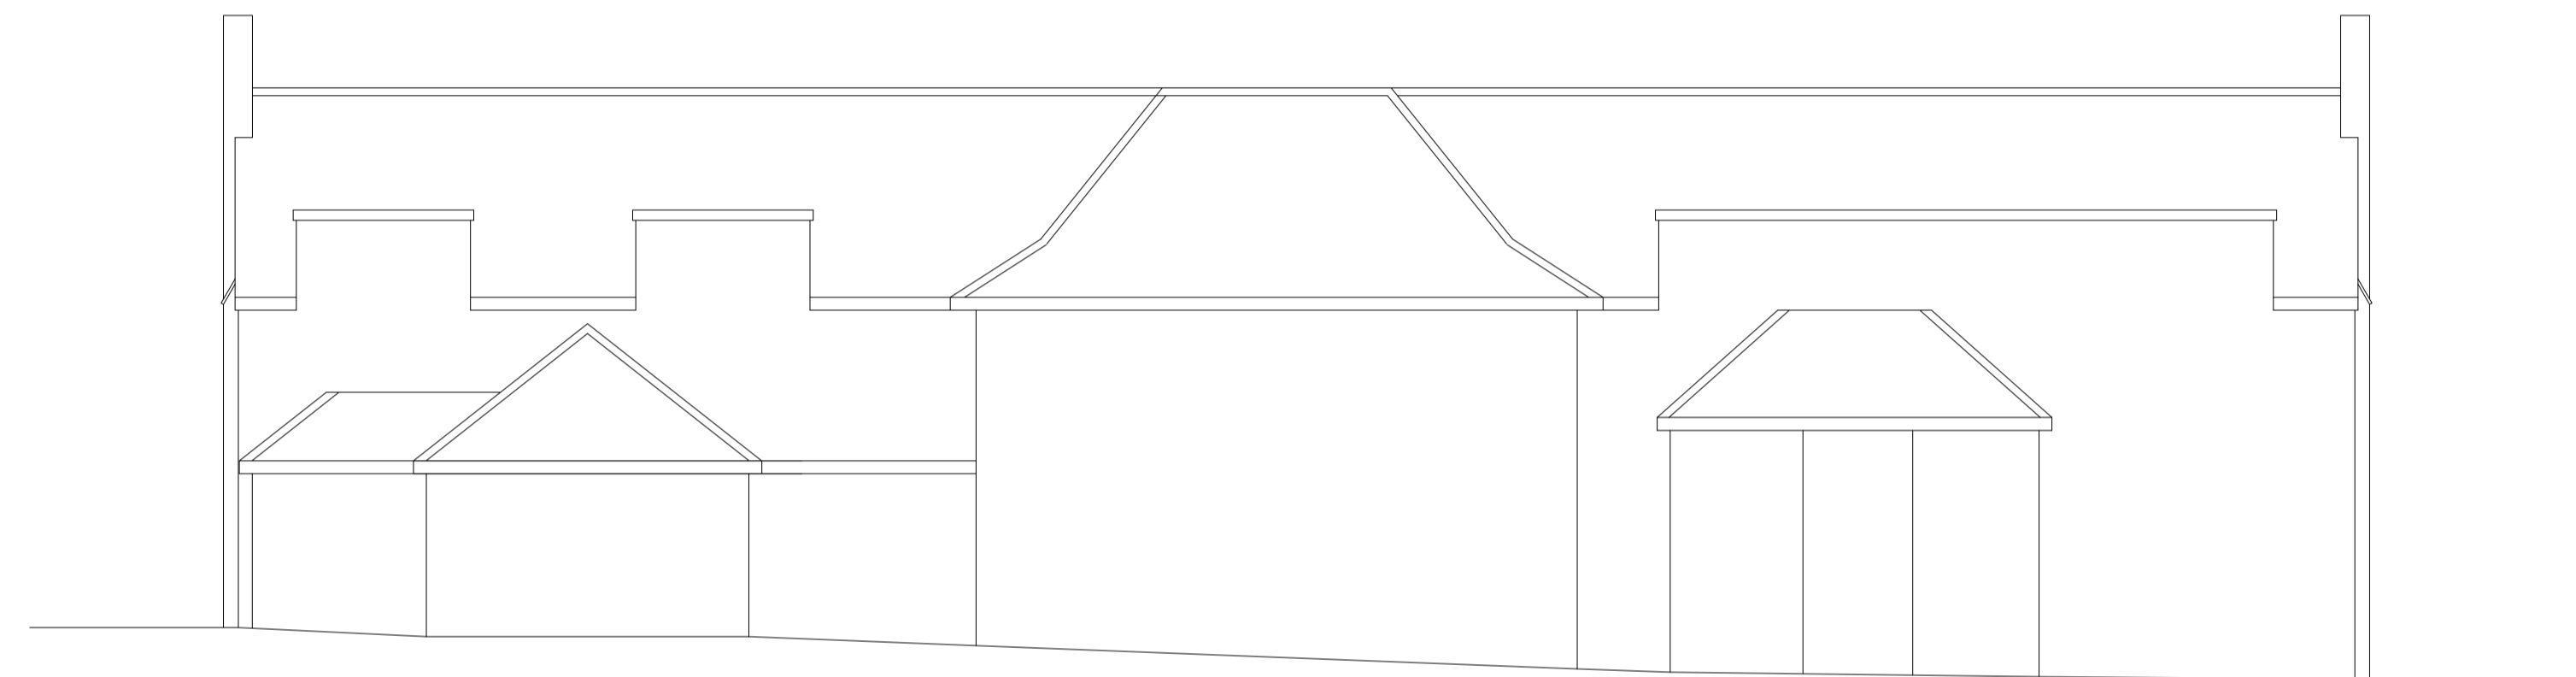

Datum 30.00

Rear Elevation - West  
Broughton House

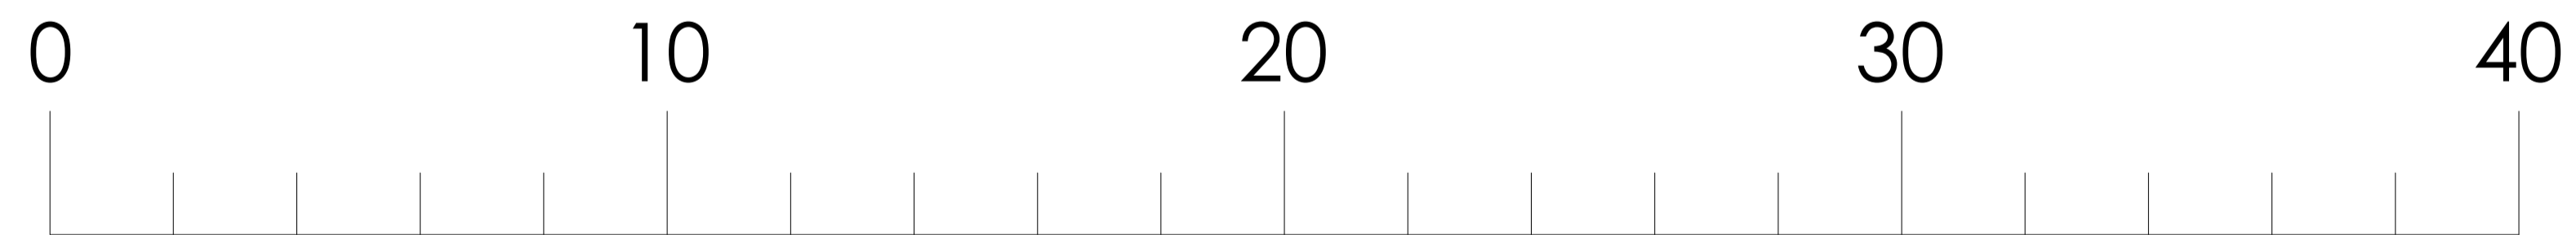

Scale bar ( meters )



**Redline  
Surveys**

callum@redlinesurveys.co.uk  
mobile: 07956 017 168

steve@redlinesurveys.co.uk  
mobile: 07557 332 421

info@redlinesurveys.co.uk  
www.redlinesurveys.co.uk

Client:  
BCP Council  
Survey at:  
Former Bournemouth &  
Poole College  
Constitution Hill Road  
Poole  
BH14 0QD

Plot 3. 22- 205  
Date: 19/03/2024  
Scale 1 : 100 A1  
Desc: Elevations

Comp by: C. Booker  
Surveyed by: S. Booker

All data has been recorded  
using a Trimble R12i GPS system

All levels relative to OSBM

the contents of this  
drawing are copyright