

Overall Area 65 x 30m

LDN Architects

29 St Leonards Road, Forres IV36 1EN  
T: 01309 673221  
F: 01309 676397  
E: architects@ldn.co.uk

Job Title:

**CANNA HOUSE  
COMPOUND**

Drawing Title:

**SITE PLAN**

Drawing Status:

**AS BUILT LAYOUT  
(APPROXIMATE)**

Drawing No:

**F2014 L(--)-001**

Scale:  
1:250



Date:  
FEB 21

Drawn:  
IJF



Reviewed:

Contractor's Compound 30x20m  
including on site parking

Stock Fence Boundary (Red)

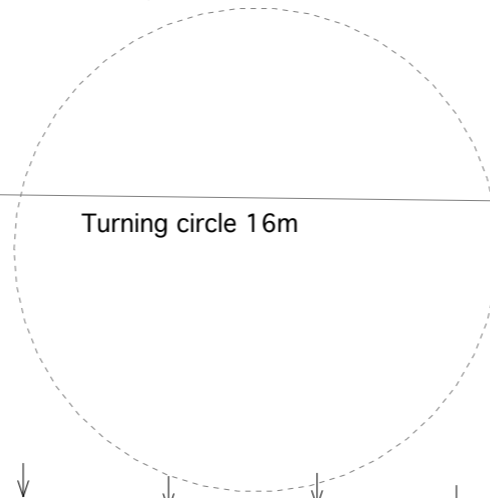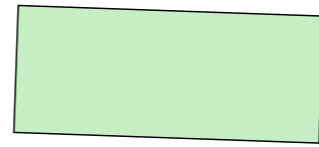

Turning circle 16m

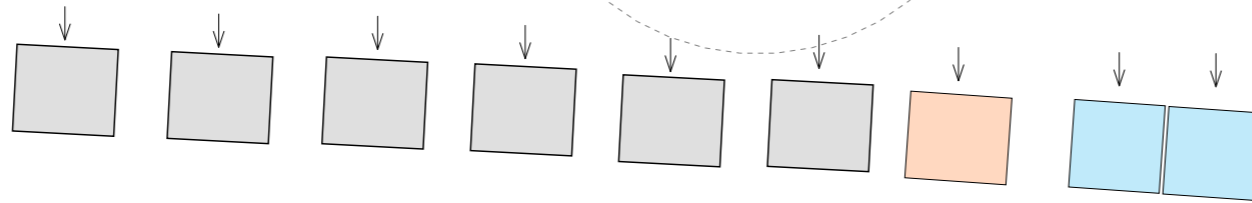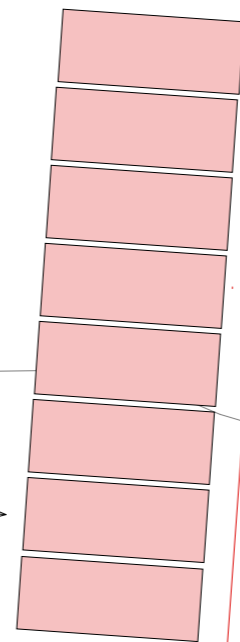


Post and Wire Fence

Water  
Toby


Septic  
Tank


**KEY**

  2870x3350mm 1 person cabin x 6

 3054x10104mm Office x 1



 2.4x6.0m Store x 8

 2592x2808mm WC x 2

 2870x3350mm Canteen

Track

High Water Mark

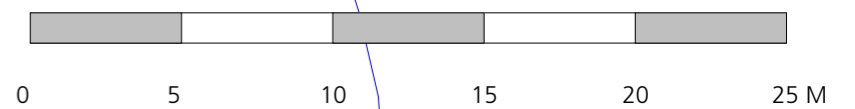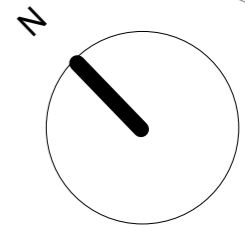

© This Drawing is copyright of LDN Architects LLP