



Notes:
 Do Not Scale. Use only figured dimensions.
 All dimensions to be checked on site prior to construction.
 Any discrepancies to be notified to the architect.
 All Copyright Reserved to **Haskins Designs Ltd.**

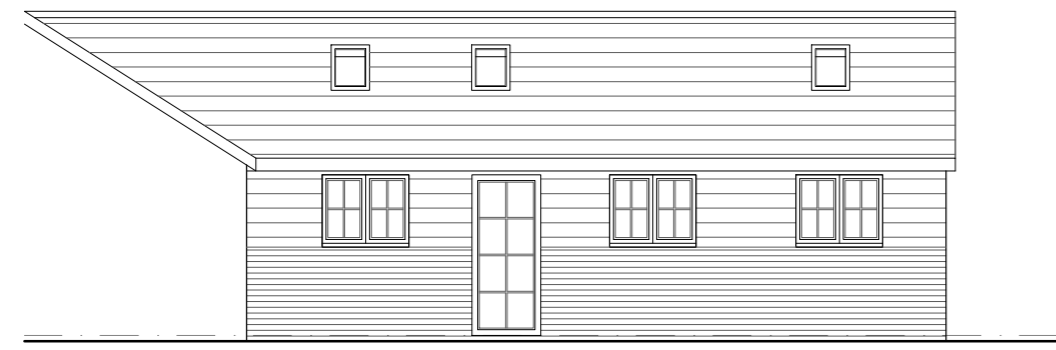


FRONT ELEVATION




SIDE ELEVATION

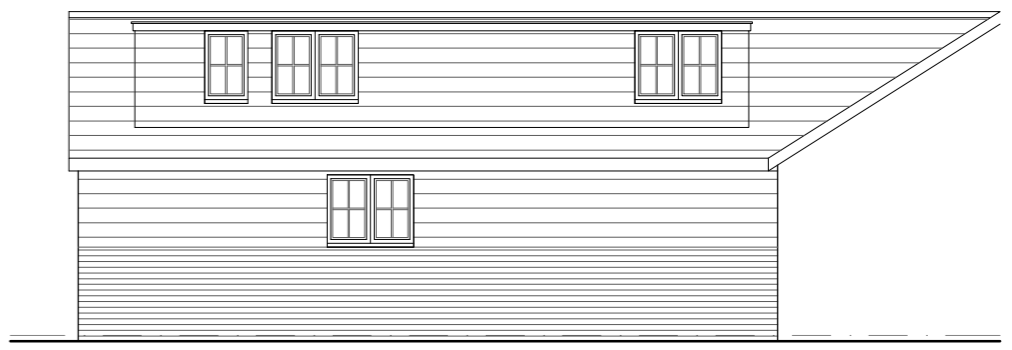


REAR ELEVATION

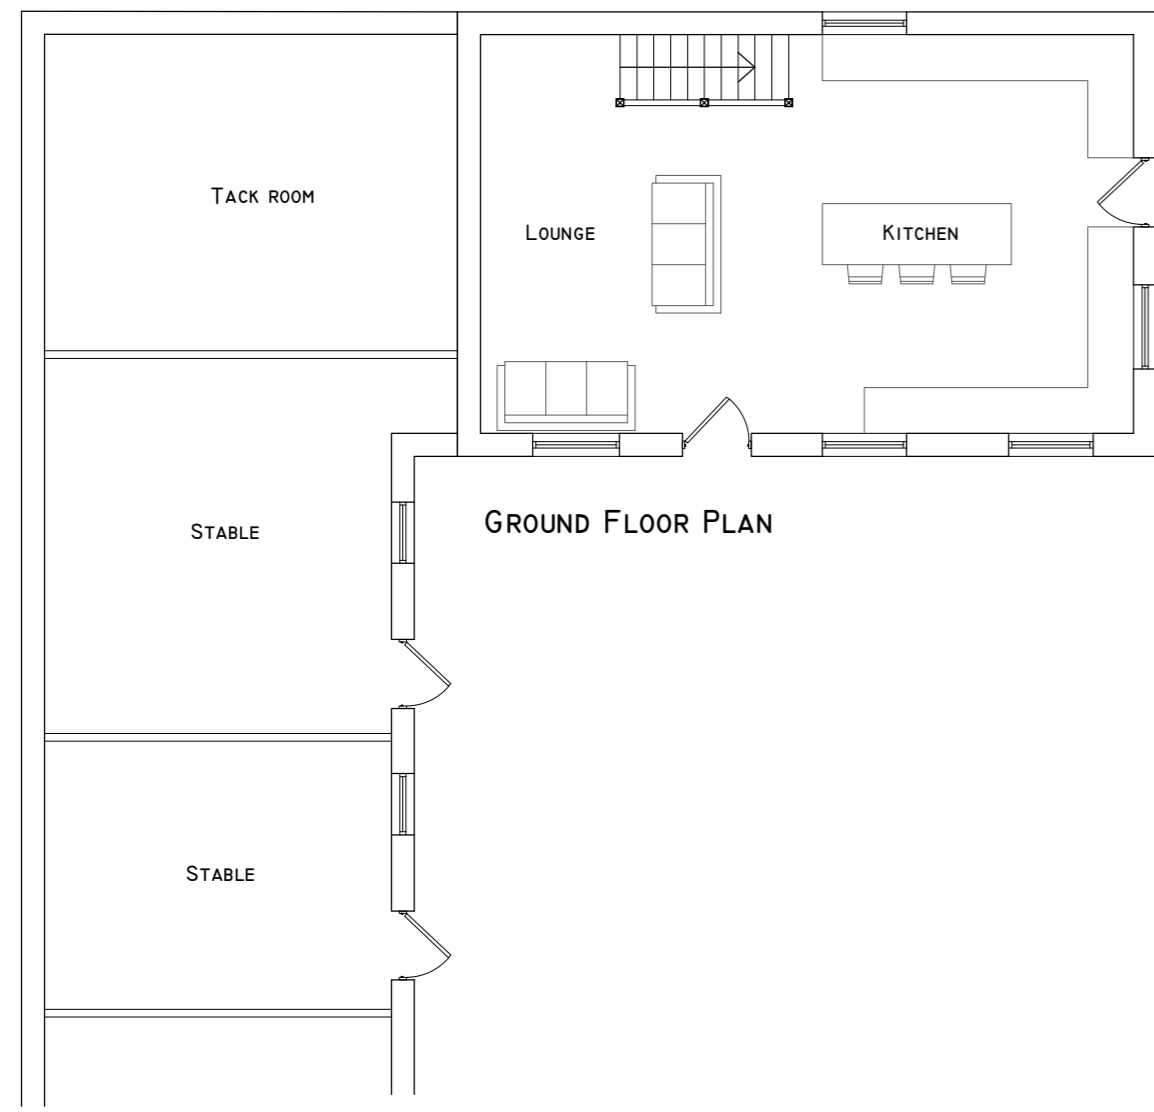

GROUND FLOOR PLAN

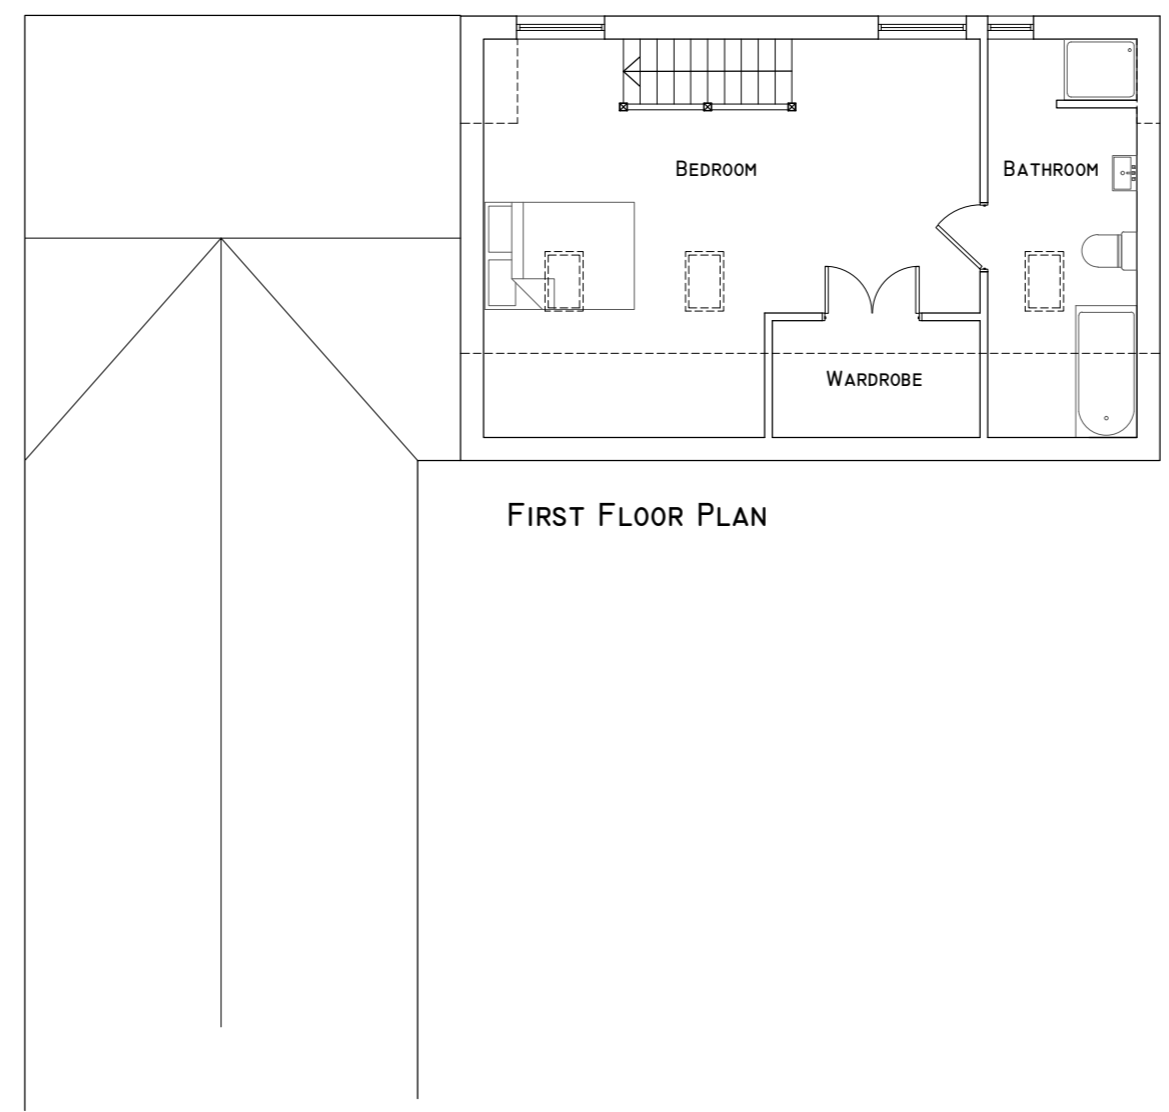

FIRST FLOOR PLAN

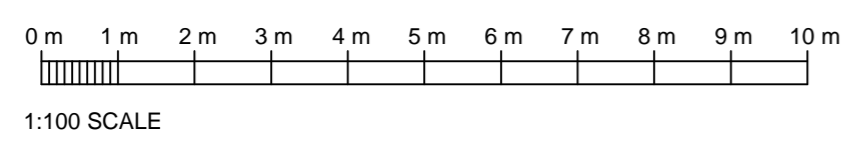

PLANNING

Client
Ms. S. Annette

Project
Mayfield
Noahs Ark
Sevenoaks
TN15 6PF



The Civic Centre, St Mary's Road, Swanley, Kent, BR8 7BU.
 Phone: 01322 479561, Mobile: 07802 162202
 info@haskinsdesigns.co.uk Website: haskinsdesigns.co.uk

Title
As-built Floor Plans
Elevations

Project No.
274

Scale
1:100 @ A2

Drawn
MH

Check
JH

Drawing No.
274-PD01

Revision

Date
SEP 23

Rev	Date	Comments	Rev	Date	Comments