

HOT STUFF CAFE`


EXISTING 11 LONG X 3.9 M WIDE PORTAKABIN CONVERTED TO CREATE CAFE / DINER WITH OUTDOOR COVERED DINING / SMOKING AREAS.

BLUE LINE INDICATES EXTENT OF EXISTING BOUNDARY UNDER OWNERSHIP OF CLIENT.

BLUE LINE INDICATES EXTENT OF EXISTING BOUNDARY UNDER OWNERSHIP OF CLIENT.

BLUE LINE INDICATES EXTENT OF EXISTING BOUNDARY UNDER OWNERSHIP OF CLIENT.


MAIN ENTRANCE TO APPLICATION SITE LEADING FROM B 1228 STREET LANE.

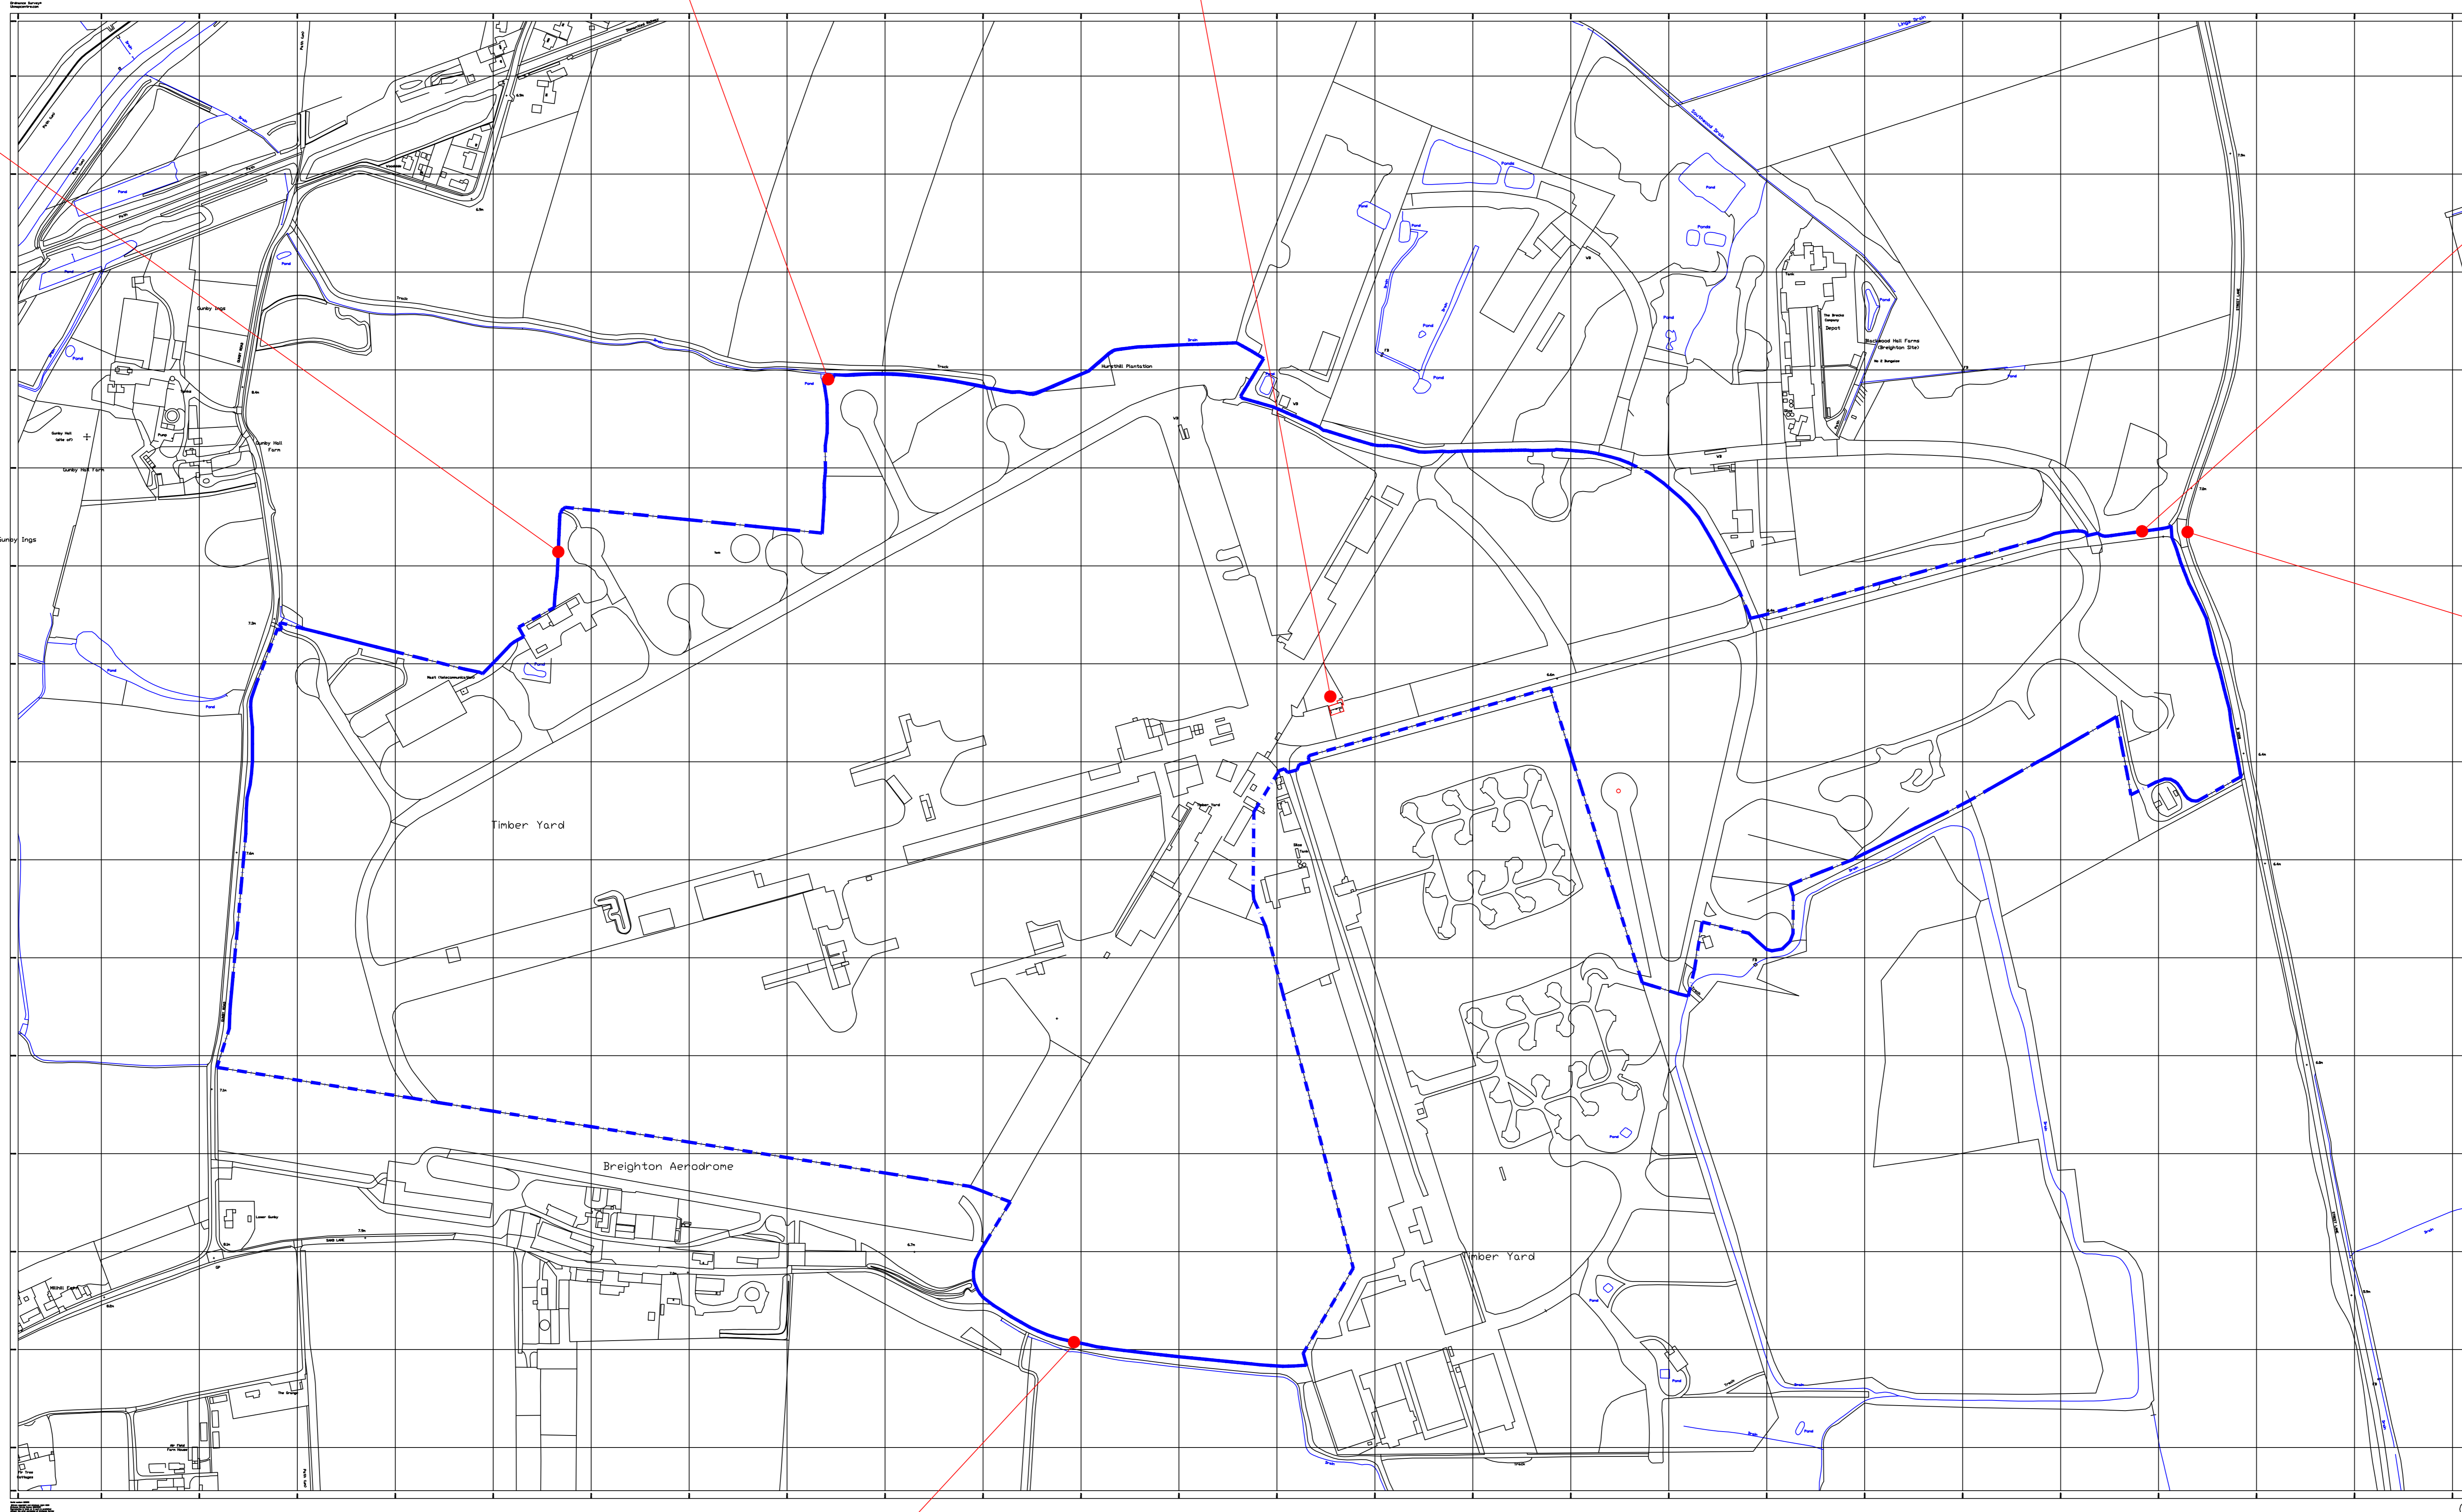

SCALE BAR > 0-50m@ 1:2500

BLUE LINE INDICATES EXTENT OF EXISTING BOUNDARY UNDER OWNERSHIP OF CLIENT.

REVISION 'A' (APRIL 2024)
Drawing amended to illustrate application site (RED LINE) and scale bar amended in accordance with Planning Officers requirements.

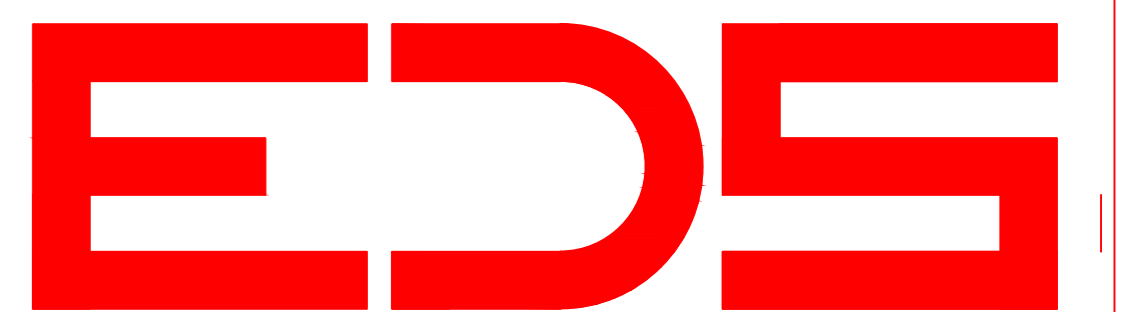

Client:
MRS P.TRIMBLE
HOT STUFF CAFE`

Location :
Brighton Airfield,
Street Lane,
Subwith,
E.R.O.Y.
YO8 6DJ.
Project:
Proposed change of use of existing 11x3.9m
Portakabin for preparation of food & drink
on the premises to designated dining area.

Drawing Title:
Existing location / site plan to identify
the location of existing Hot Stuff cafe` diner.

Drawing Scale : Date :
1:2500 April 2024

Drawing Number: Rev:
C.CON.04.24.SK01 A

