


02

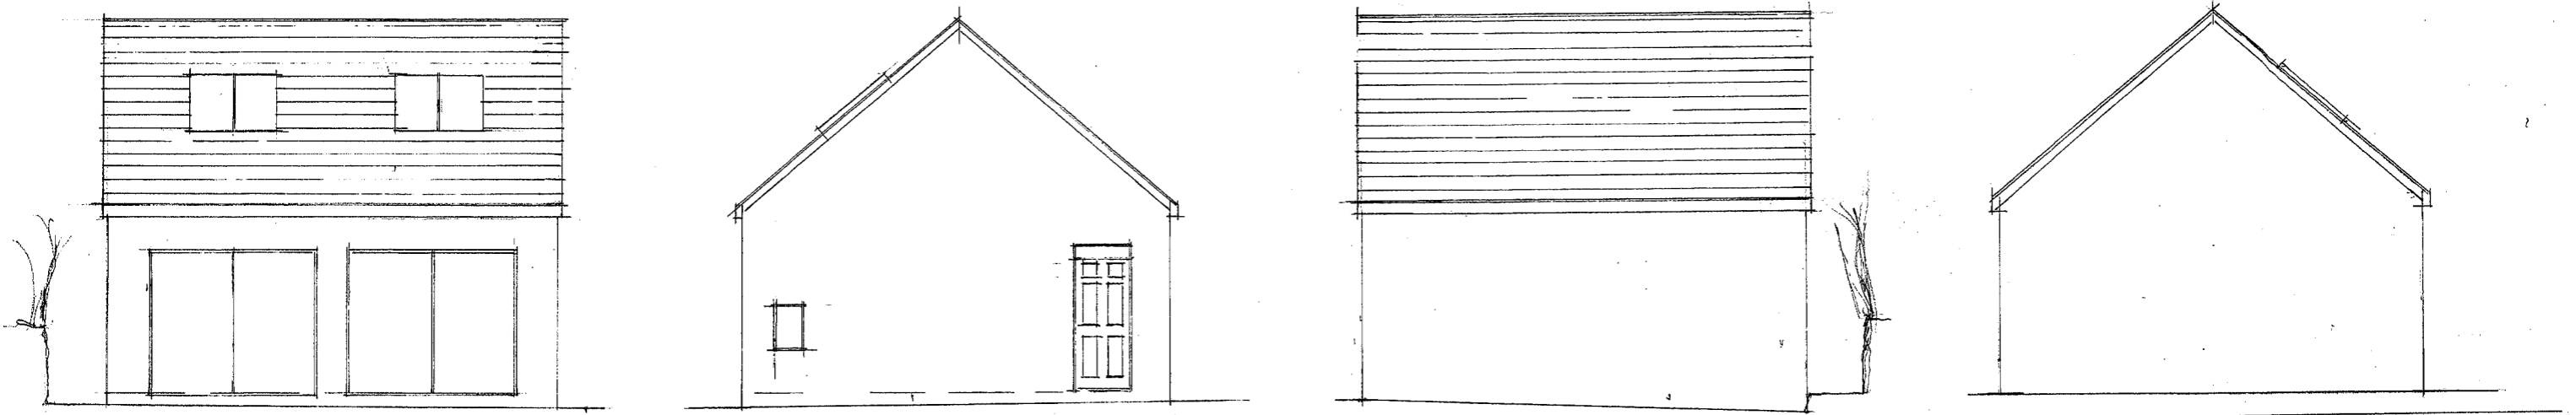


EAST  
ELEVATION


NORTH

WEST



SOUTH

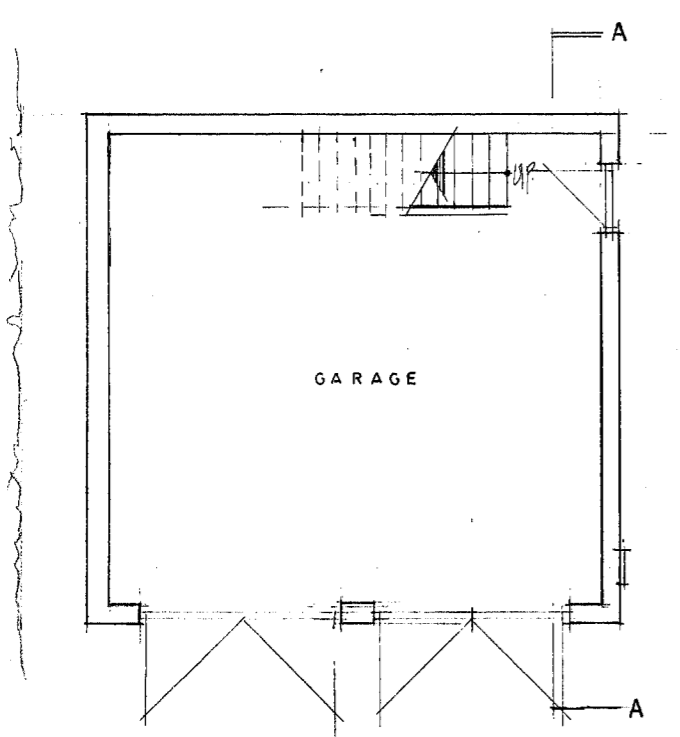


GROUND  
AS BUILT DOMESTIC GARAGE

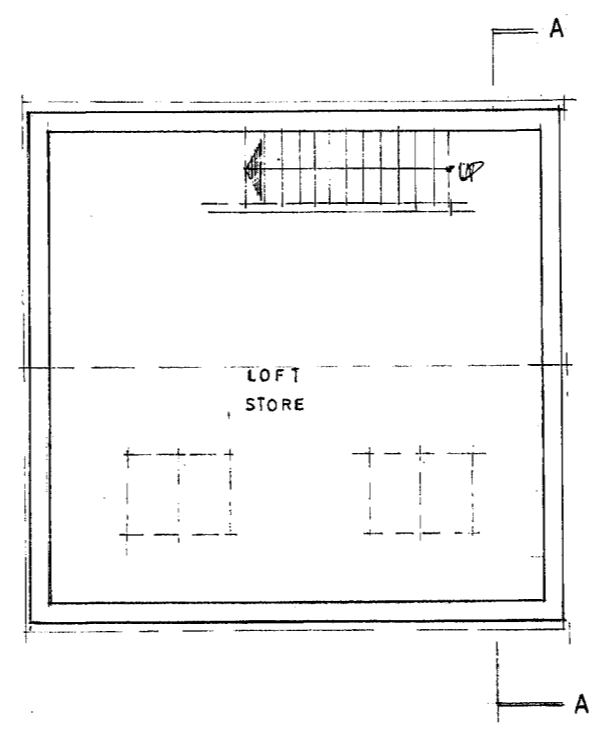

LOFT

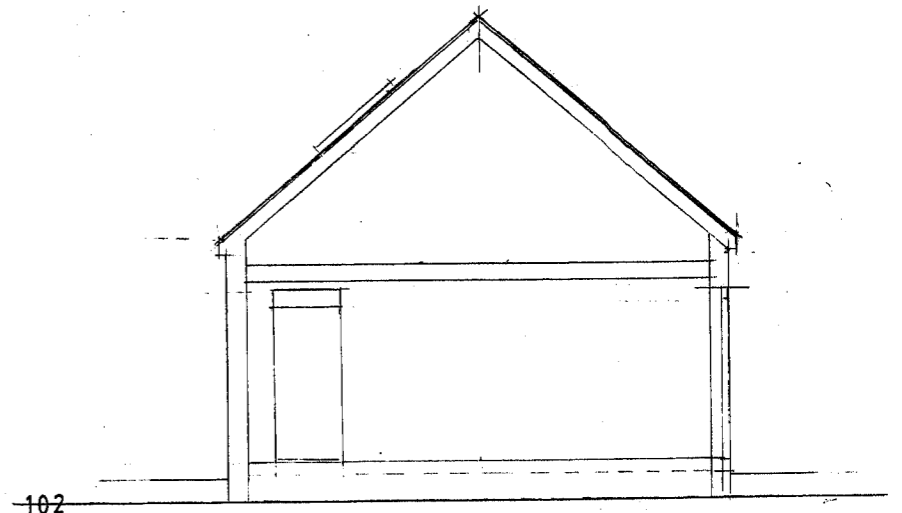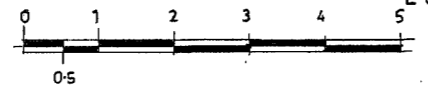

SECTION A : A

 <p><b>Simon J Ellis &amp; Co.</b> Architectural Planning &amp; Building Management Consultants</p> <p>Tel: 01579 343756 Mobile: 07774 849885 mail@simonjellis.co.uk</p> <p>Woodhill Manor Barns, Liskeard, Cornwall. PL14 6RD. Principal: Simon J. Ellis</p>	<p>Job Title: ALTERATION, CONVERSION &amp; EXTENSION TO FORM A DWELLING, ON LAND ADJ. TO MINEFIELD COTTAGES, MENHENIOT</p>
	<p>Date: <b>FEB 2024</b>      Scale: 1:100 at A3</p>
	<p>Drawing No.: <b>1141/02</b></p>
	<p>Do not scale for construction purposes. © Copyright</p>