



SIDE ELEVATIONS




FRONT

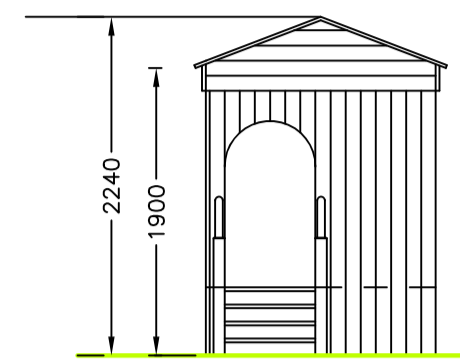


FRONT ELEVATIONS

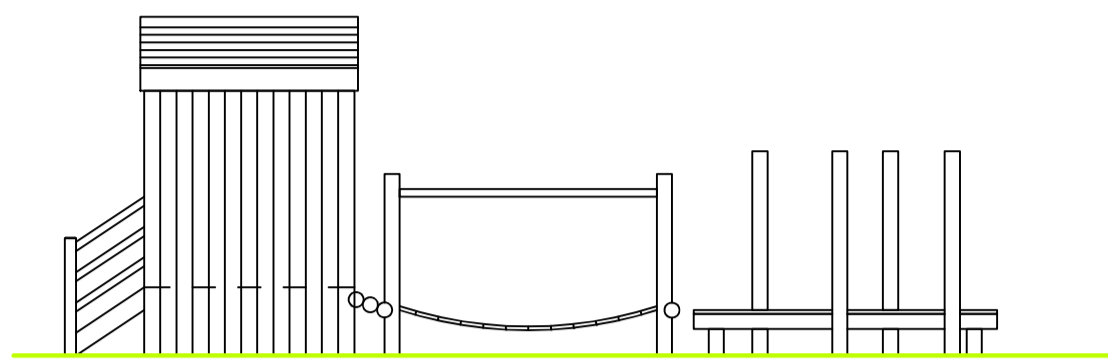


SIDE

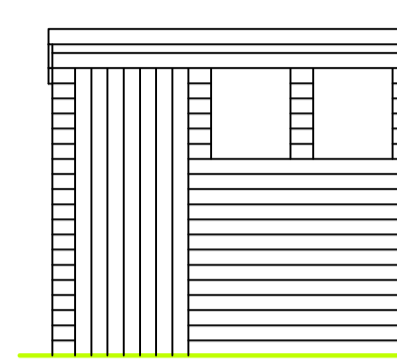


FRONT ELEVATIONS

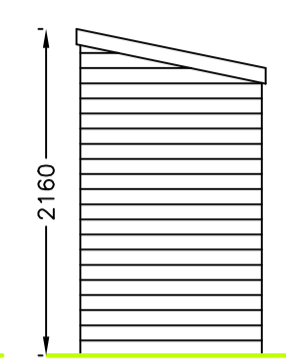


SIDE

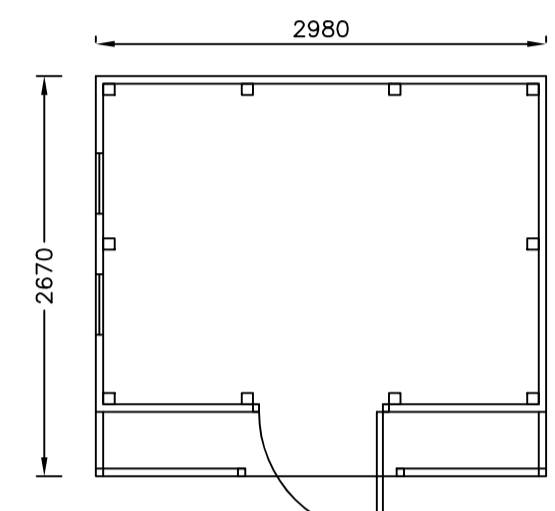


PLAN PRE-EXISTING WENDY HOUSE

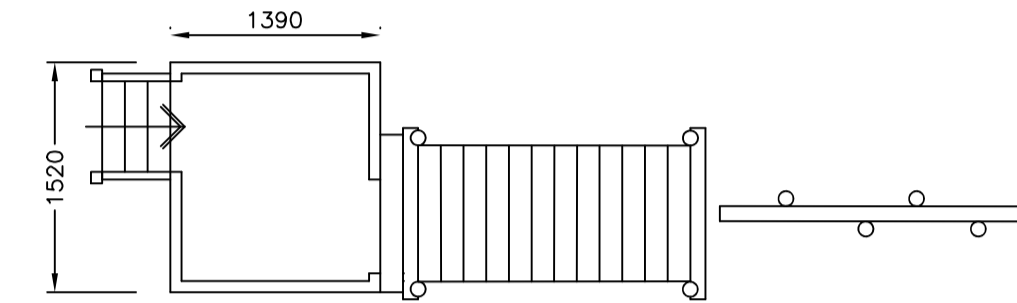


"PEEKABOO" TOWER PLAN

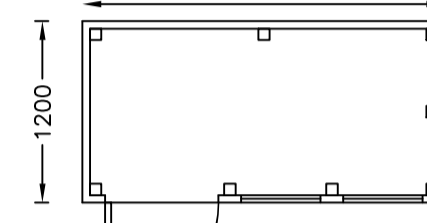


PLAN PRE-EXISTING SHED

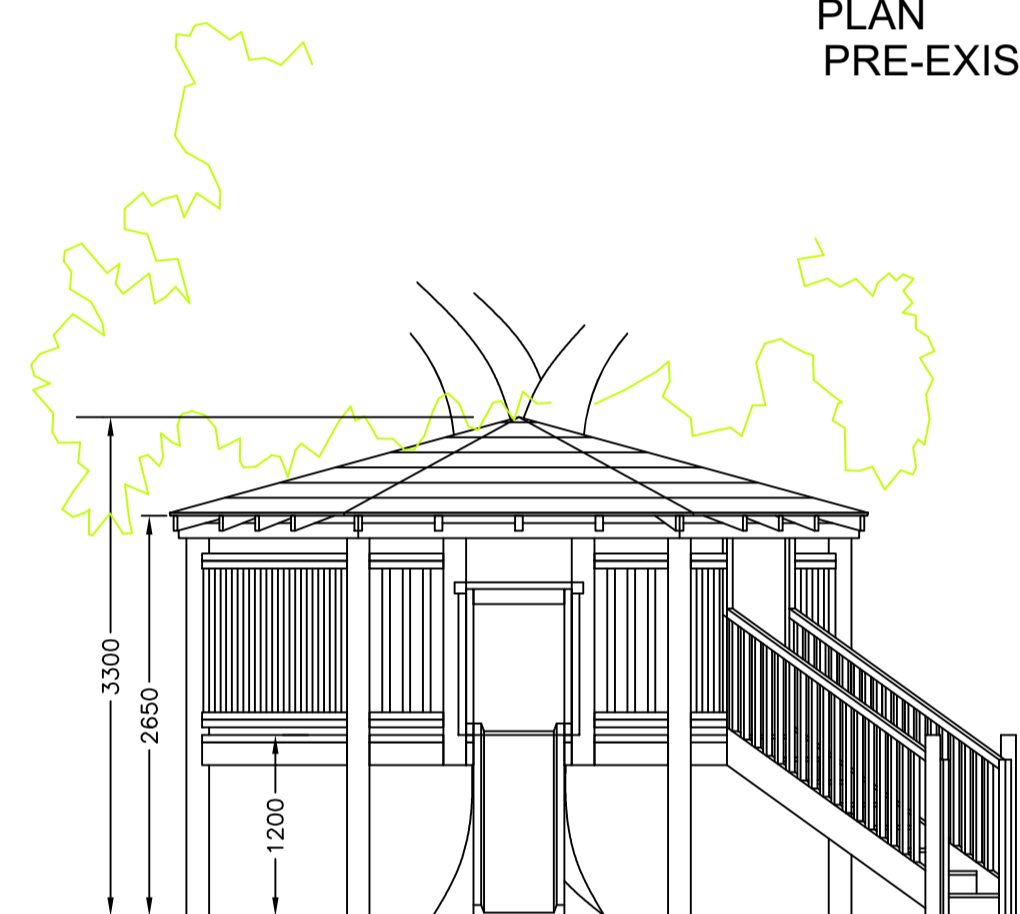


FRONT ELEVATIONS

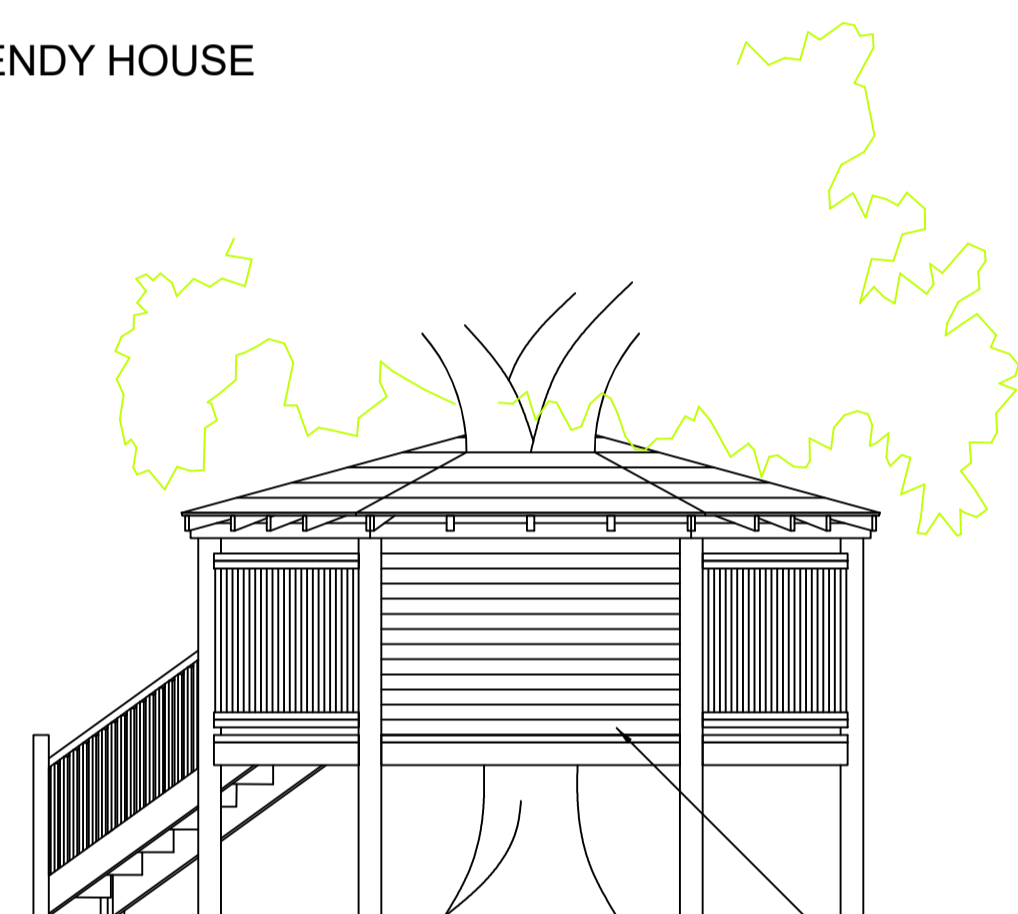


REAR

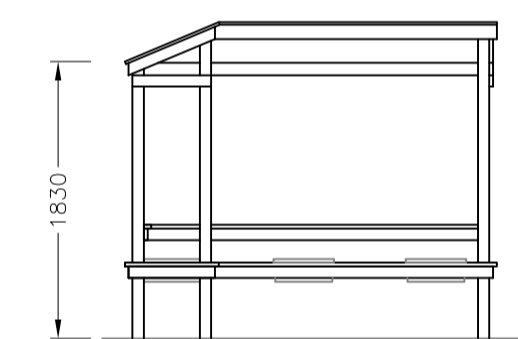


FRONT ELEVATIONS

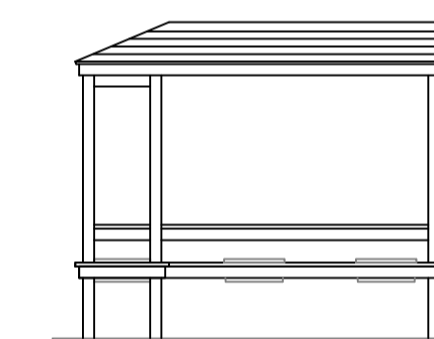


SIDE

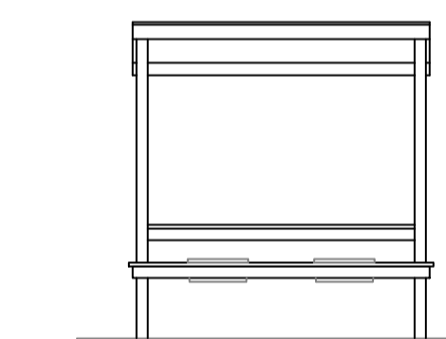


FRONT ELEVATIONS

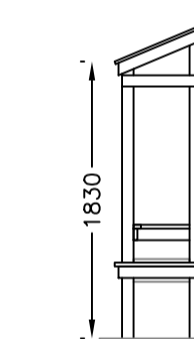


SIDE

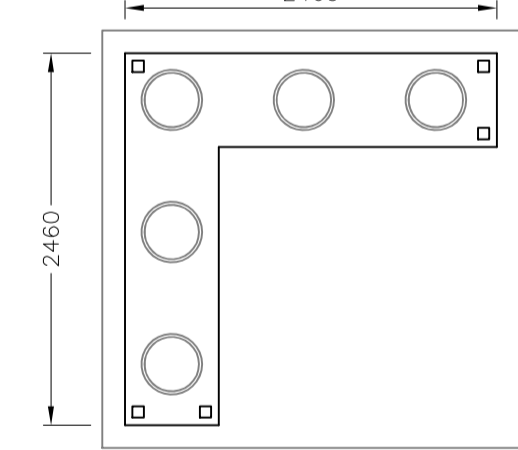

PLAN MUD KITCHEN 1

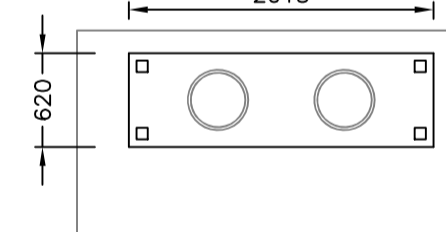


PLAN MUD KITCHEN 2

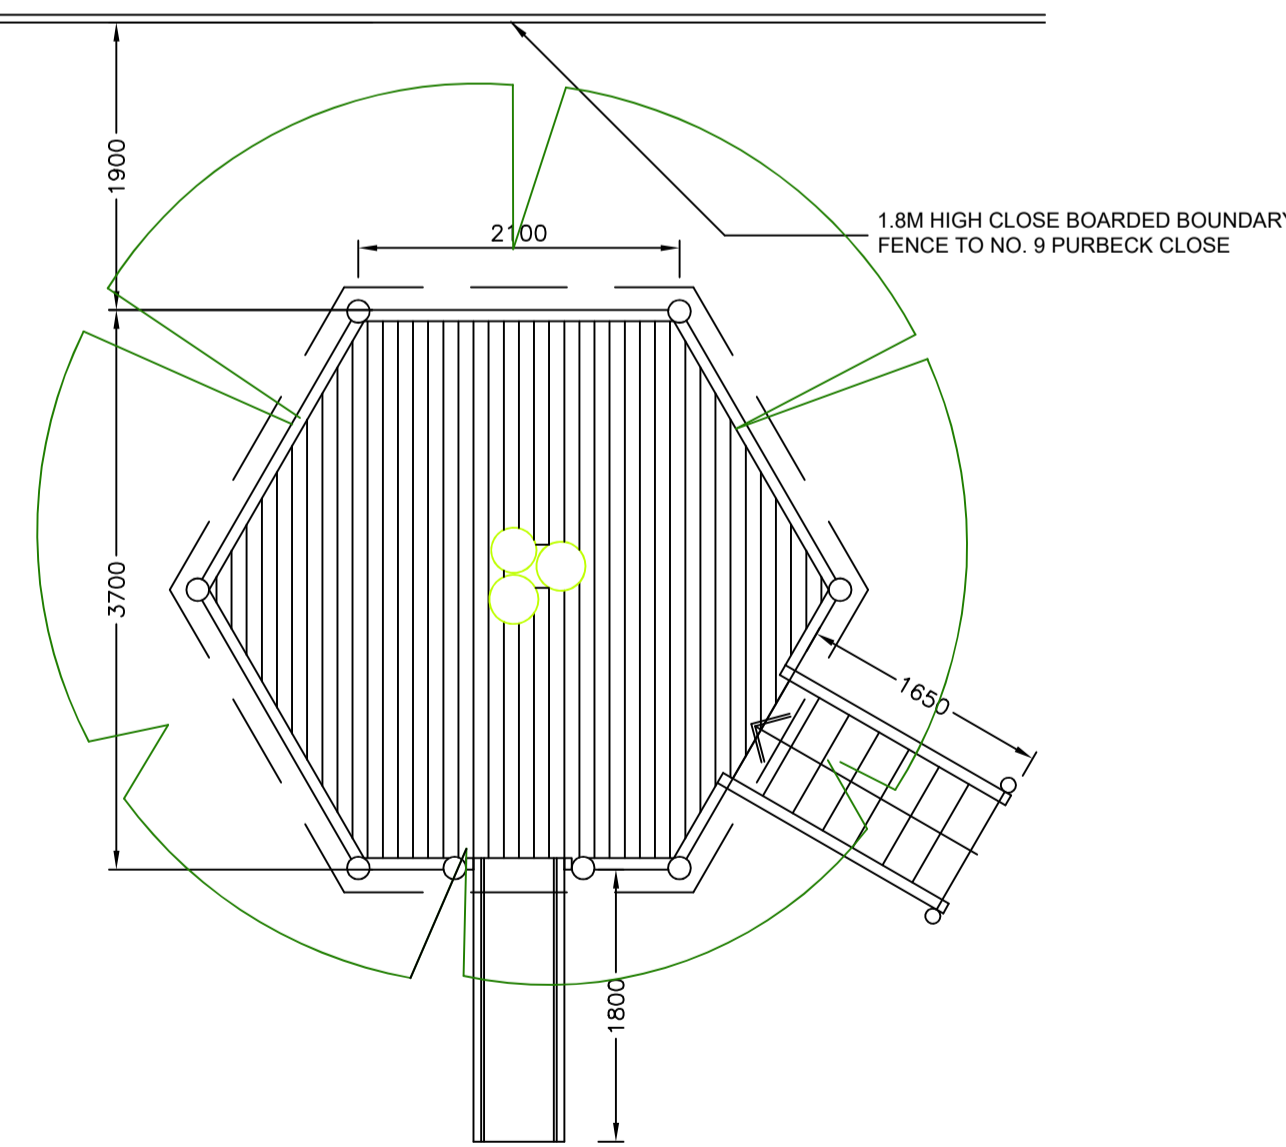


TREE HOUSE PLAN

ALL PLAY EQUIPMENT AND STRUCTURES CONSTRUCTED FROM TIMBER

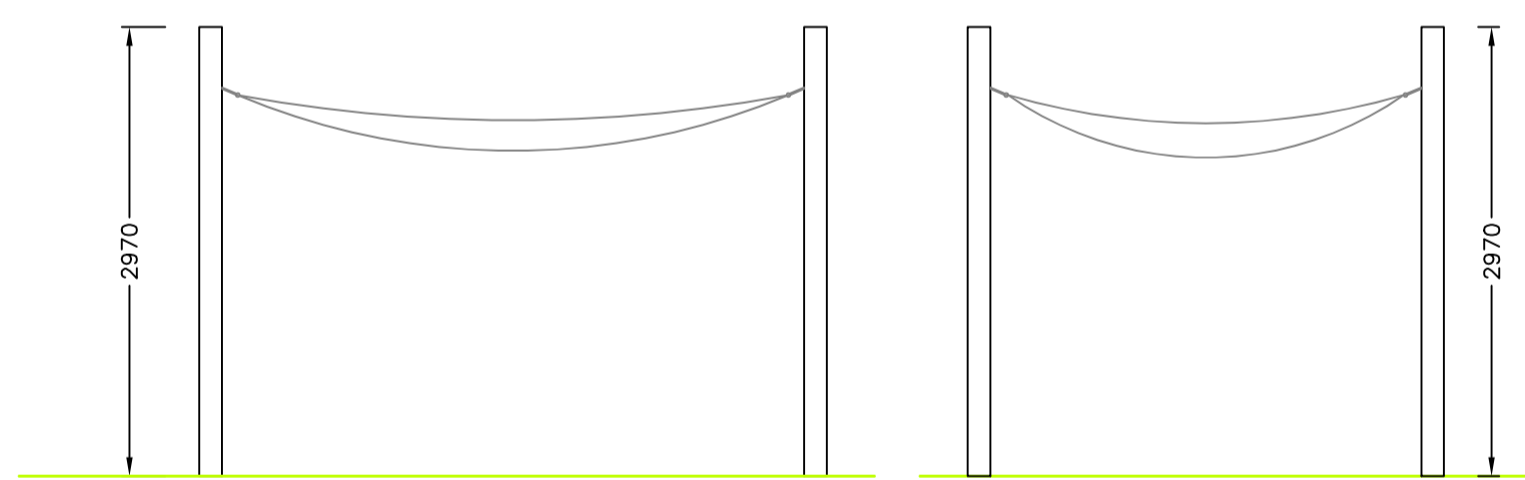


ELEVATION


ELEVATION

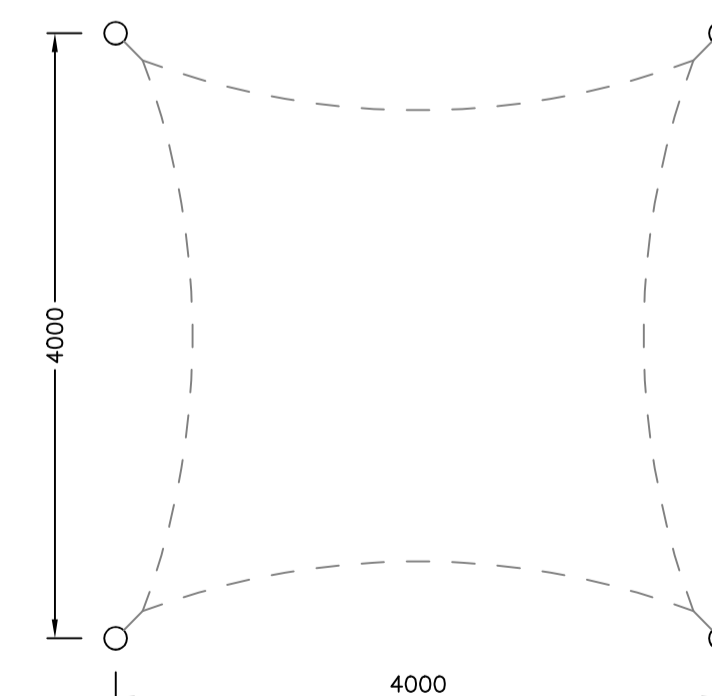

SHADE SAIL 1 PLAN

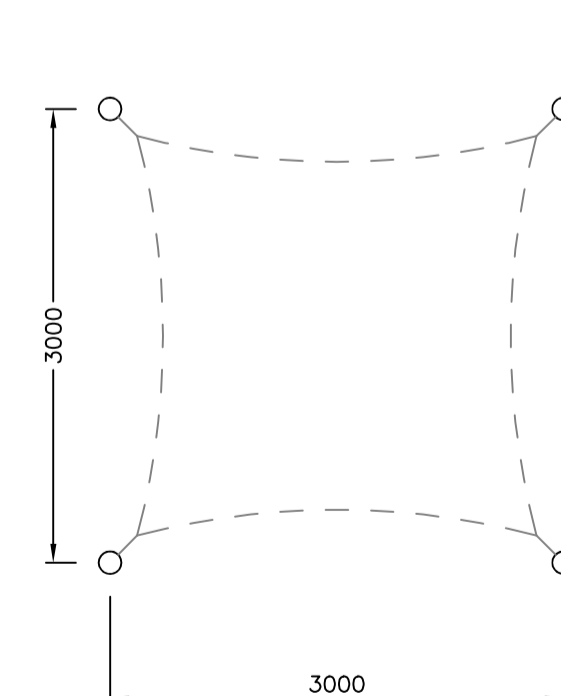

SHADE SAIL 2 PLAN

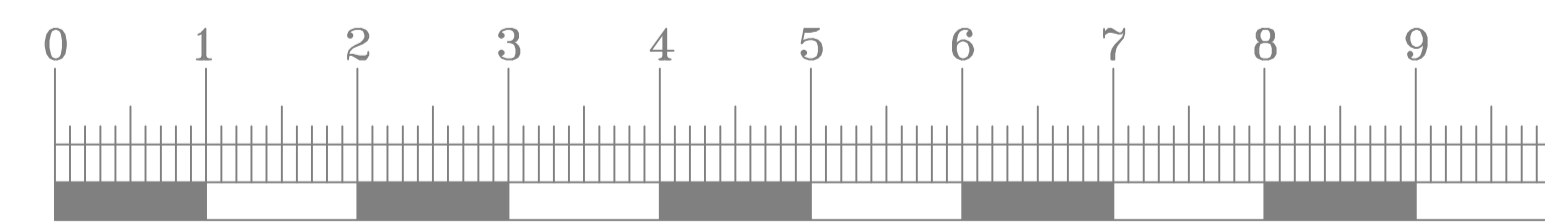

A 03-04-2024 As built.

Hives Associates
CHARTERED SURVEYOR

Scales Dyke,
19 Main Street,
Lyddington,
Oakham,
Rutland, LE15 9LR
TEL OAKHAM 01572 823825
FAX 01572 823925
Mobile: 07768 694095

Client:
Childbase Partnership Ltd

Project:
244 Wendover Road
Aylesbury
Bucks HP21 9PD

Drawing title:
Existing and Proposed play equipment

Drawn by: M Hives
Date: 3rd April 2024

Drawing Number:
500-54-2-703

Scale: 1:50@A1

THIS DRAWING IS COPYRIGHT © THIS DRAWING IS NOT TO BE SCALED.
DIMENSIONS TO BE SITE CHECKED BEFORE COMMENCEMENT OF WORK.
HIVES ASSOCIATES LTD TO BE NOTIFIED OF ANY OMISSIONS OR ERRORS.