

Do not scale this drawing. All dimensions must be checked on site. Copyright © Studio Six Architecture Ltd. All Rights Reserved. No reproduction in any material form is permitted without consent. All dimensions are in mm.




ADDRESS 1 C4DI	ADDRESS 2 Queen St.	CITY Hull	POSTCODE HU1 1UU
-------------------	------------------------	--------------	---------------------

WEBSITE
www.studio-six.co.uk

NOTES

Proposed extension to side as per approval: 22/01270/PLB & 22/01269/PLF - Not constructed at time of survey

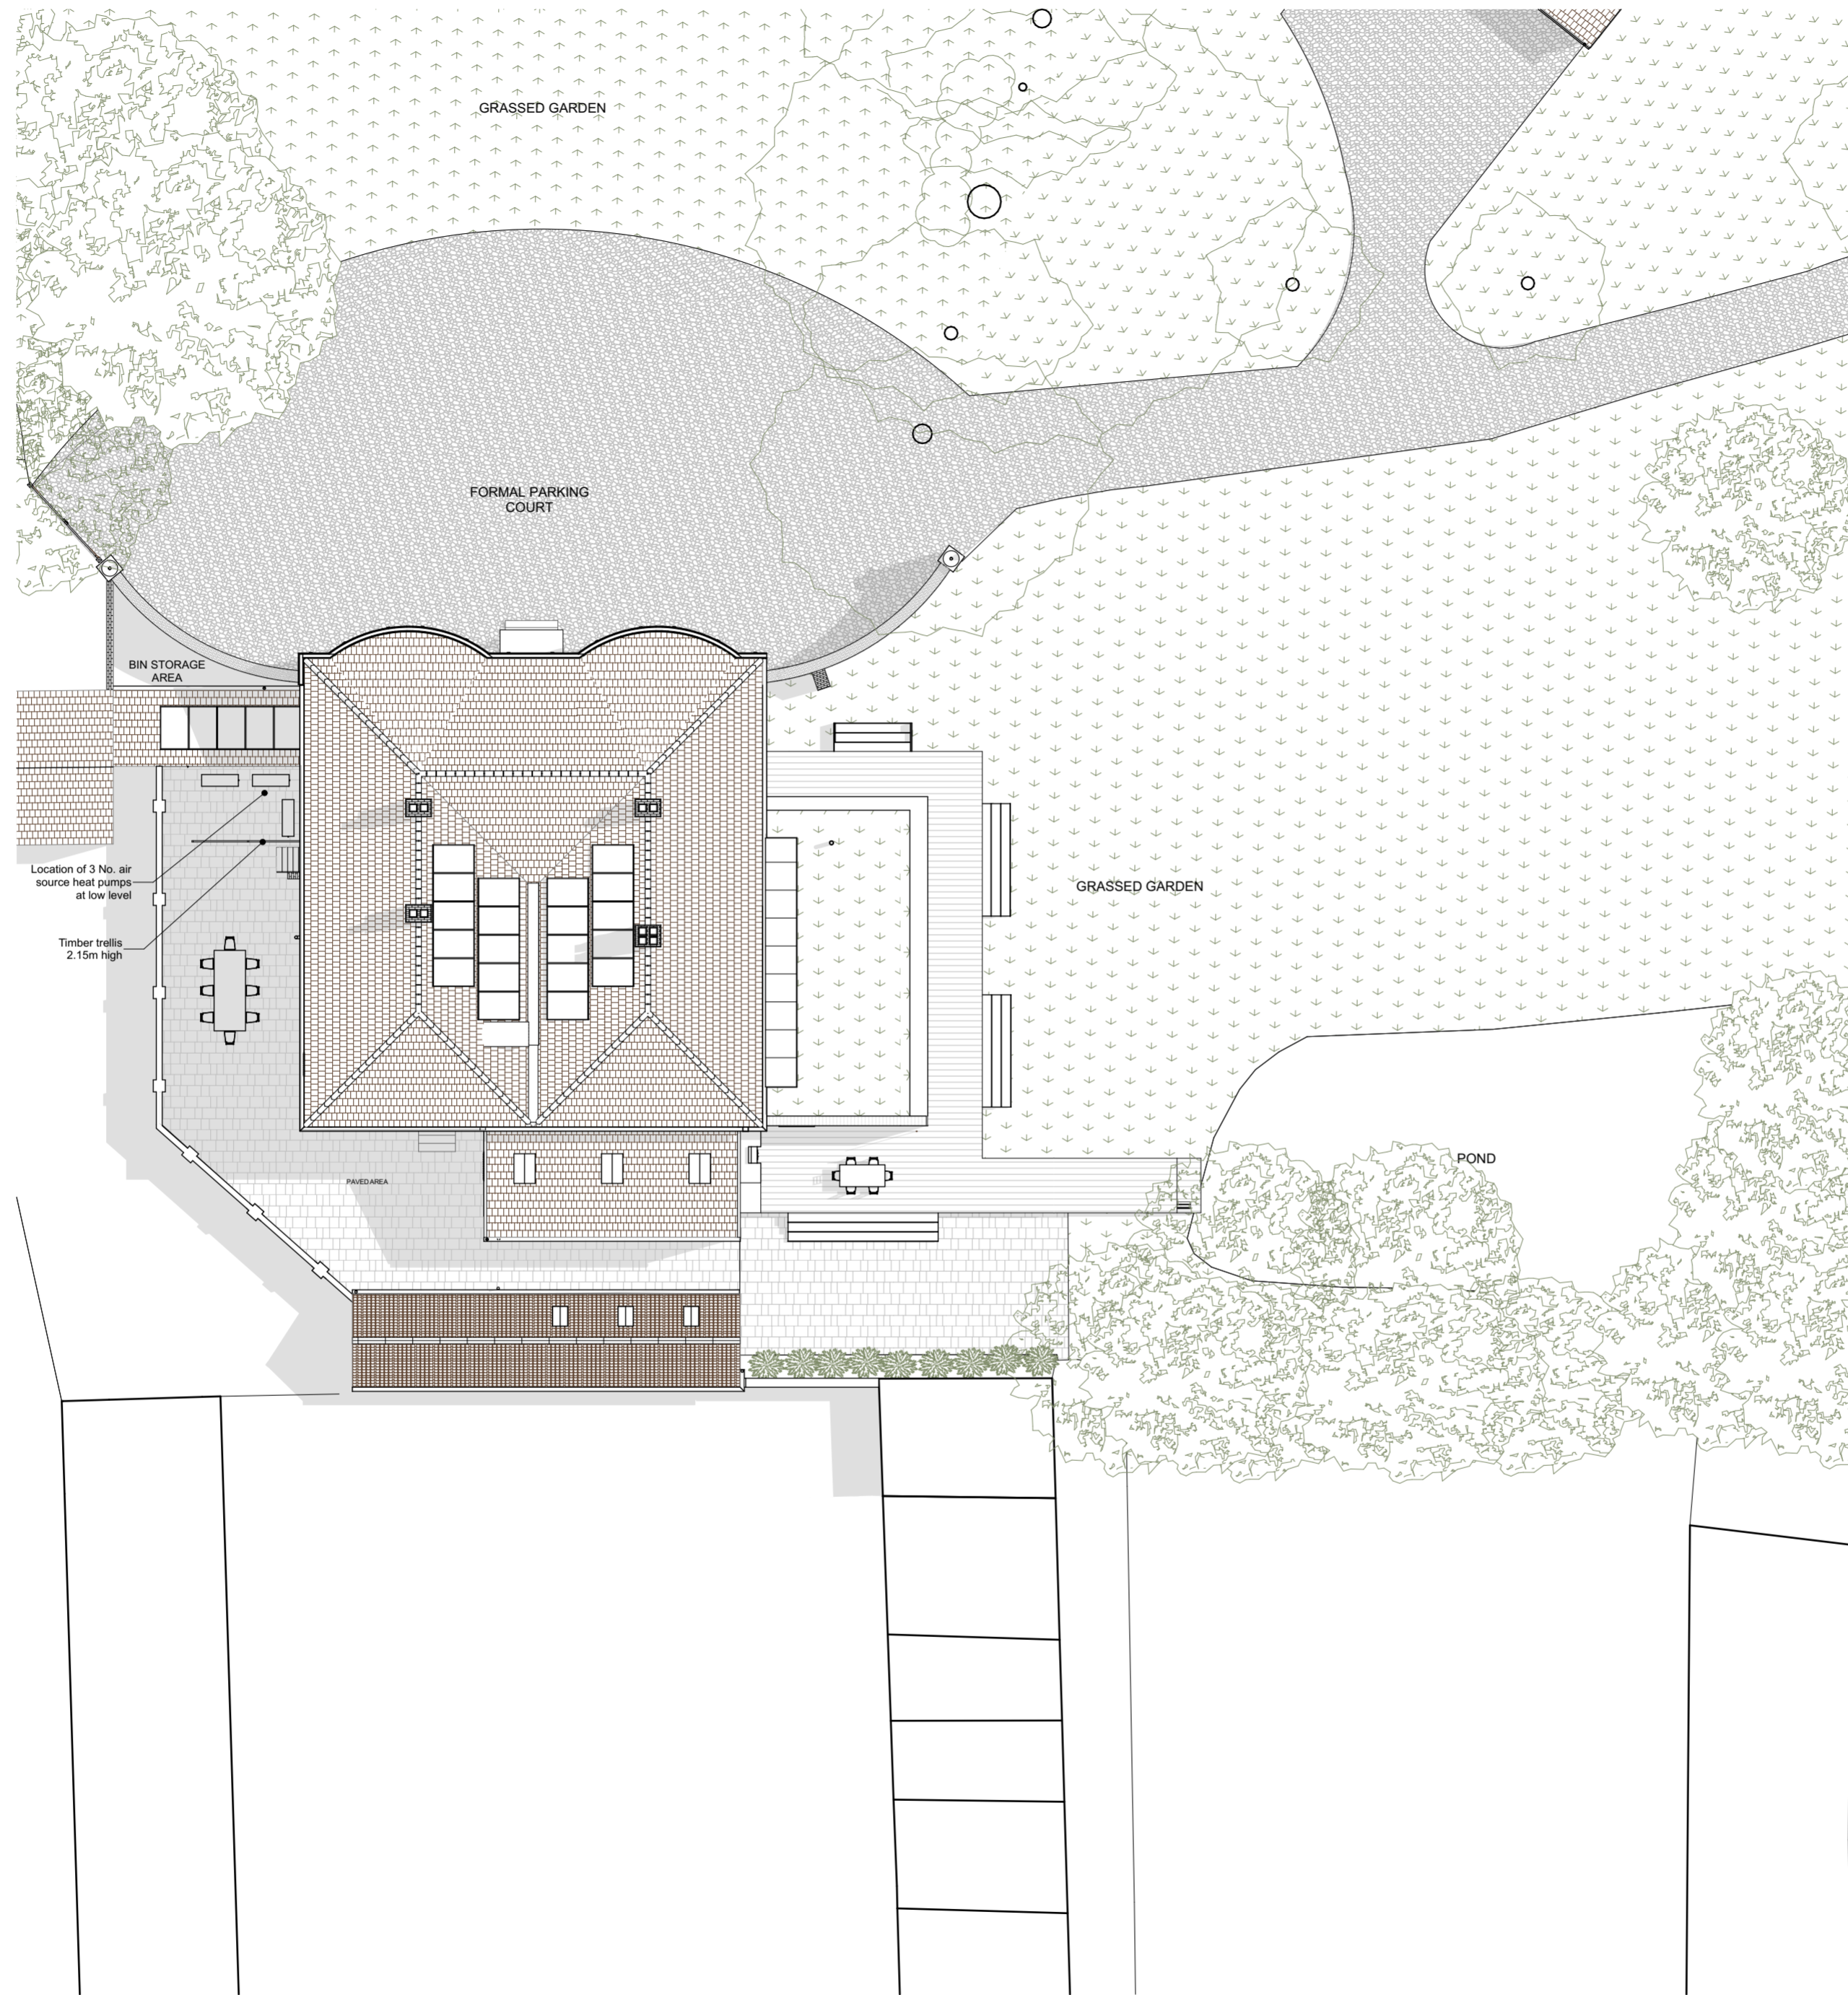

STATUS Planning	SCALE 1:200 @ A2
--------------------	---------------------

CLIENT
Mr & Mrs Holroyd-Doveton

PROJECT TITLE
Installation of Air Source Heat Pumps to Grade II listed building

PROJECT ADDRESS
Humbleton Hall
Fitting Road
Humbleton
HU11 4NS

DRAWING TITLE
ASHP Block Plan - as Built

PROJECT NO. 140	DRAWING NO. 803	REVISION B
--------------------	--------------------	---------------

DATE 05/04/2024	DRAWN HP	CHECKED MJR
--------------------	-------------	----------------

REVISIONS

Rev A	11/03/2024	Minor amendments
Rev B	11/03/2024	Minor amendments

1:200
0 1 2 4 6 8 10m