

Do not scale this drawing. All dimensions must be checked on site. Copyright © Studio Six Architecture Ltd. All Rights Reserved. No reproduction in any material form is permitted without consent. All dimensions are in mm.




ADDRESS 1: C4DI  
 ADDRESS 2: Queen St.  
 CITY: Hull  
 POSTCODE: HU1 1UU

WEBSITE: www.studio-six.co.uk


**KEY**  
 Denotes indicative lines of pipework

**NOTES**  
 Drawings show elements in their "as built" state  
 Drawings are indicative

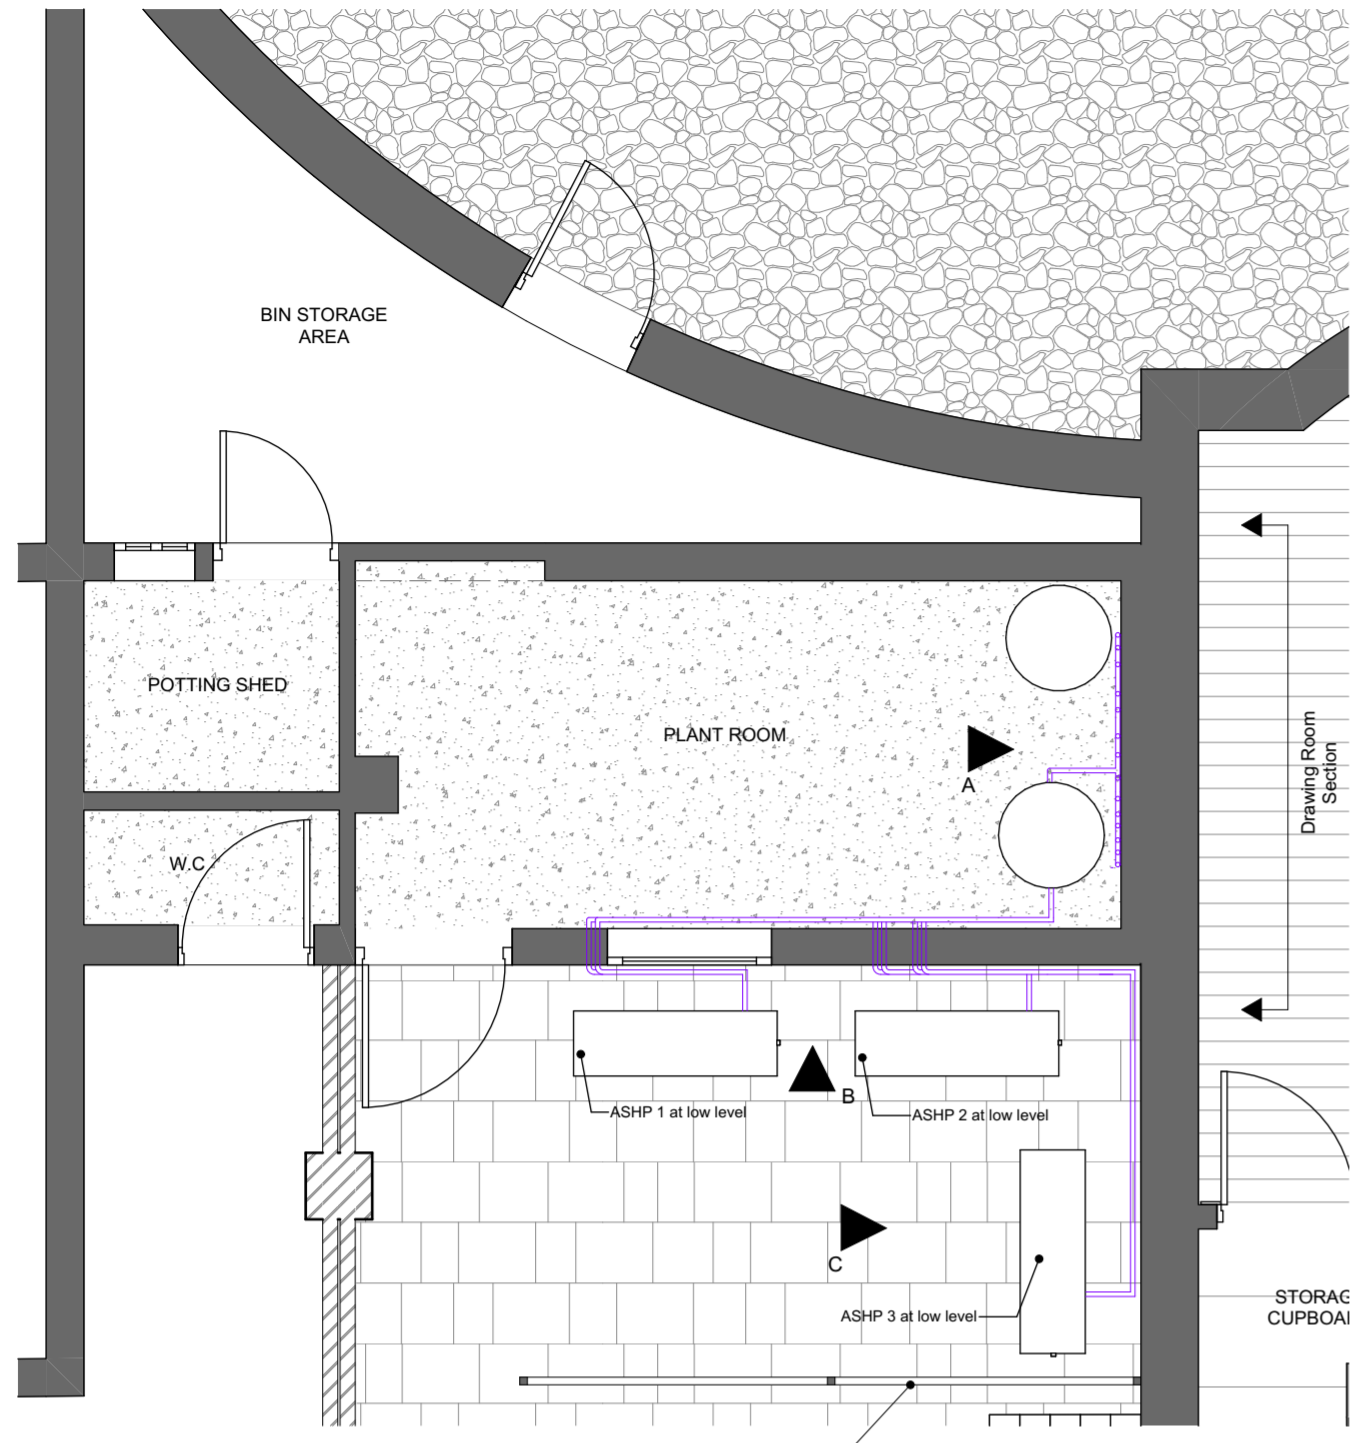


**01 | GENERAL ARRANGEMENT PLAN**  
 SCALE 1:50


Proposed timber trellis 2.15m high

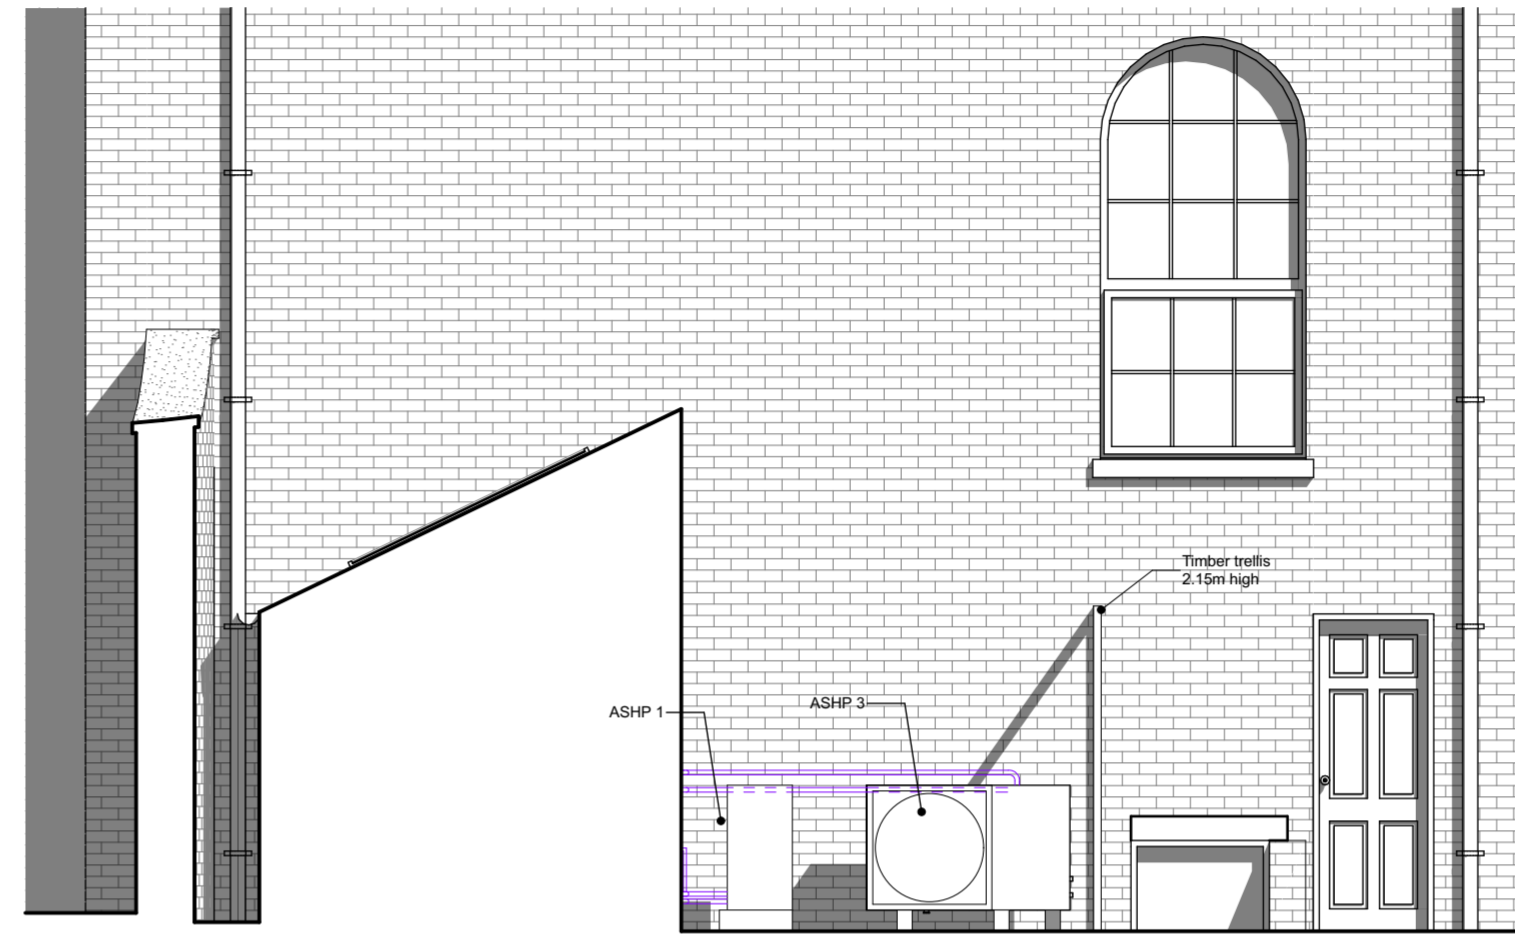


**02 | ELEVATION C**  
 SCALE 1:50

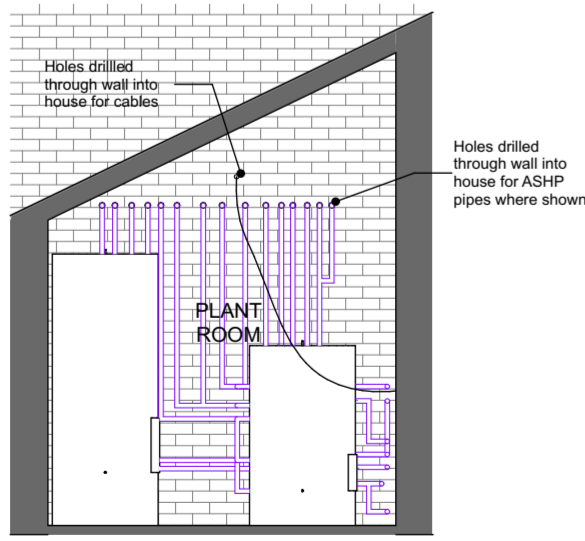

**03 | ELEVATION A**  
 SCALE 1:50

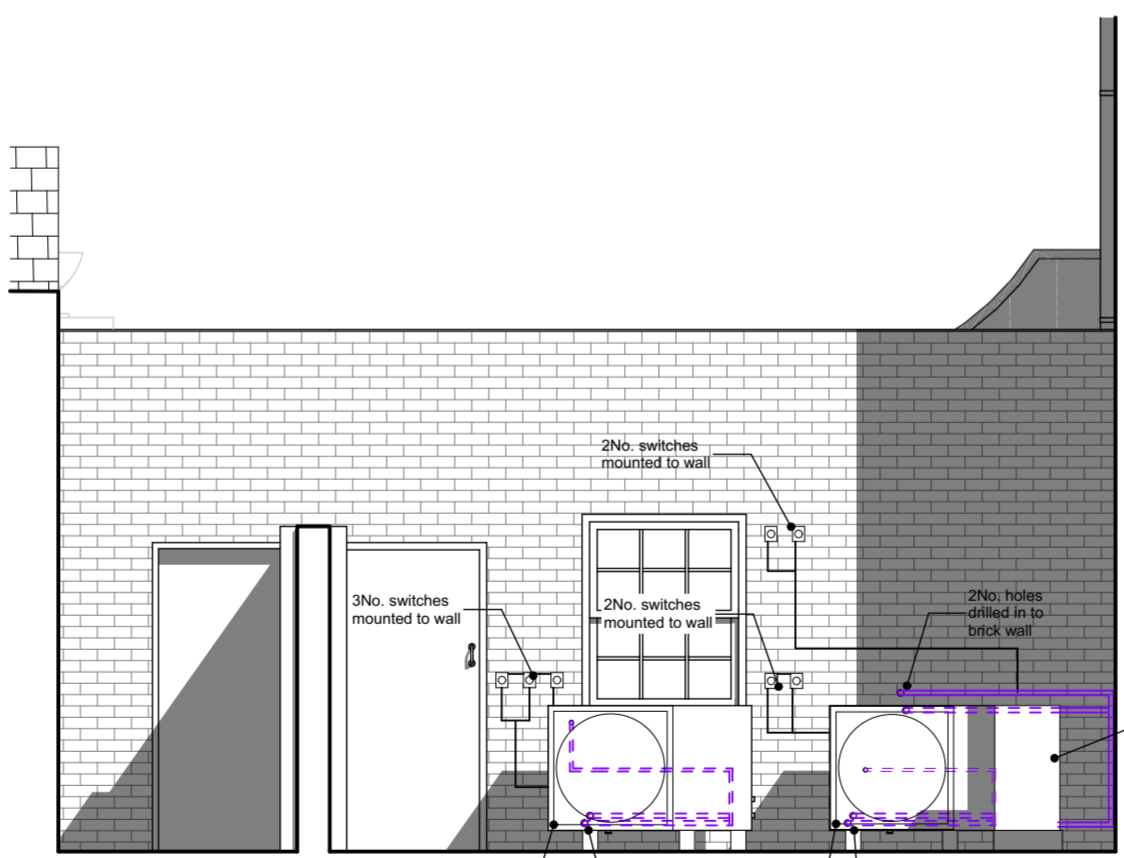

**04 | ELEVATION B**  
 SCALE 1:50

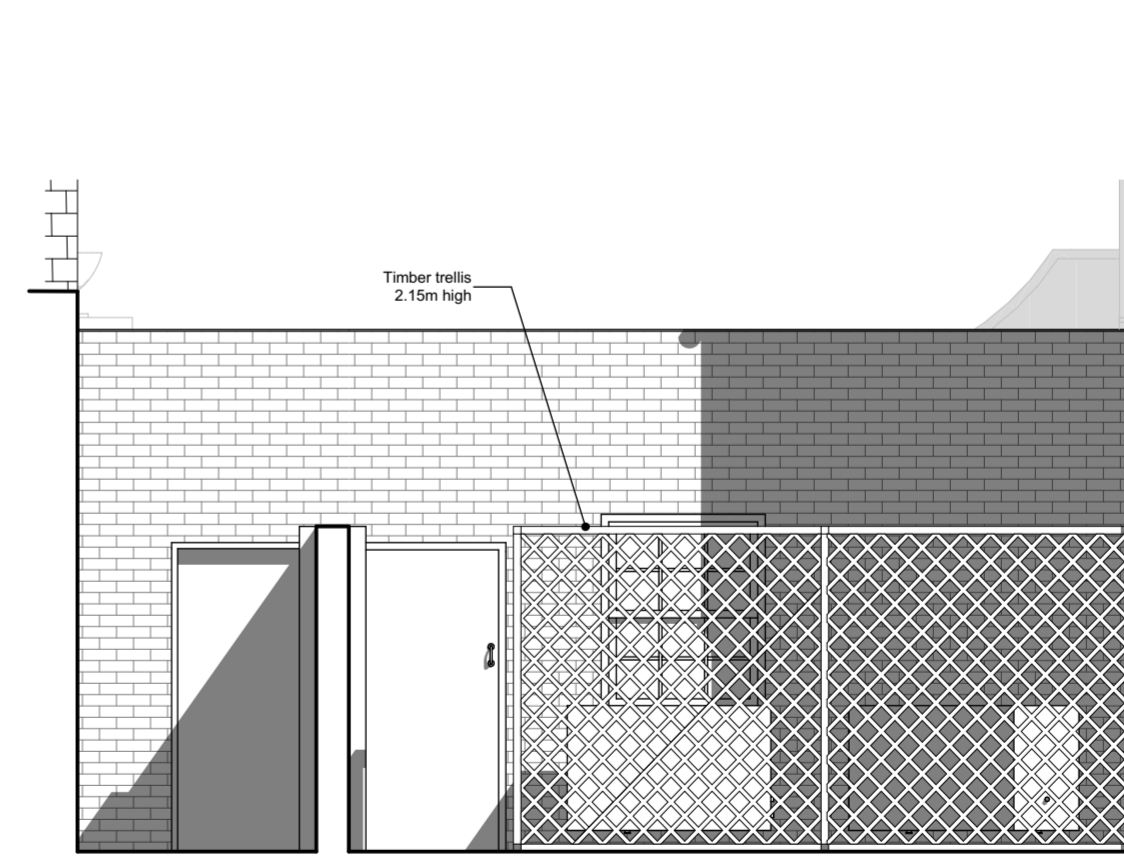

**05 | TRELLIS EXAMPLE ELEVATION**  
 SCALE 1:50



STATUS	SCALE
Planning	1:50, 1:1 @ A2

CLIENT: Mr & Mrs Holroyd-Doveton

PROJECT TITLE: Installation of Air Source Heat Pumps to Grade II listed building

PROJECT ADDRESS: Humbleton Hall, Fitting Road, Humbleton, HU11 4NS

DRAWING TITLE: ASHP Plan and Elevations - as Built

PROJECT NO.	DRAWING NO.	REVISION
140	802	A

DATE	DRAWN	CHECKED
11/03/2024	HP	MJR

REVISIONS
Rev A 11/03/2024 Minor amendments