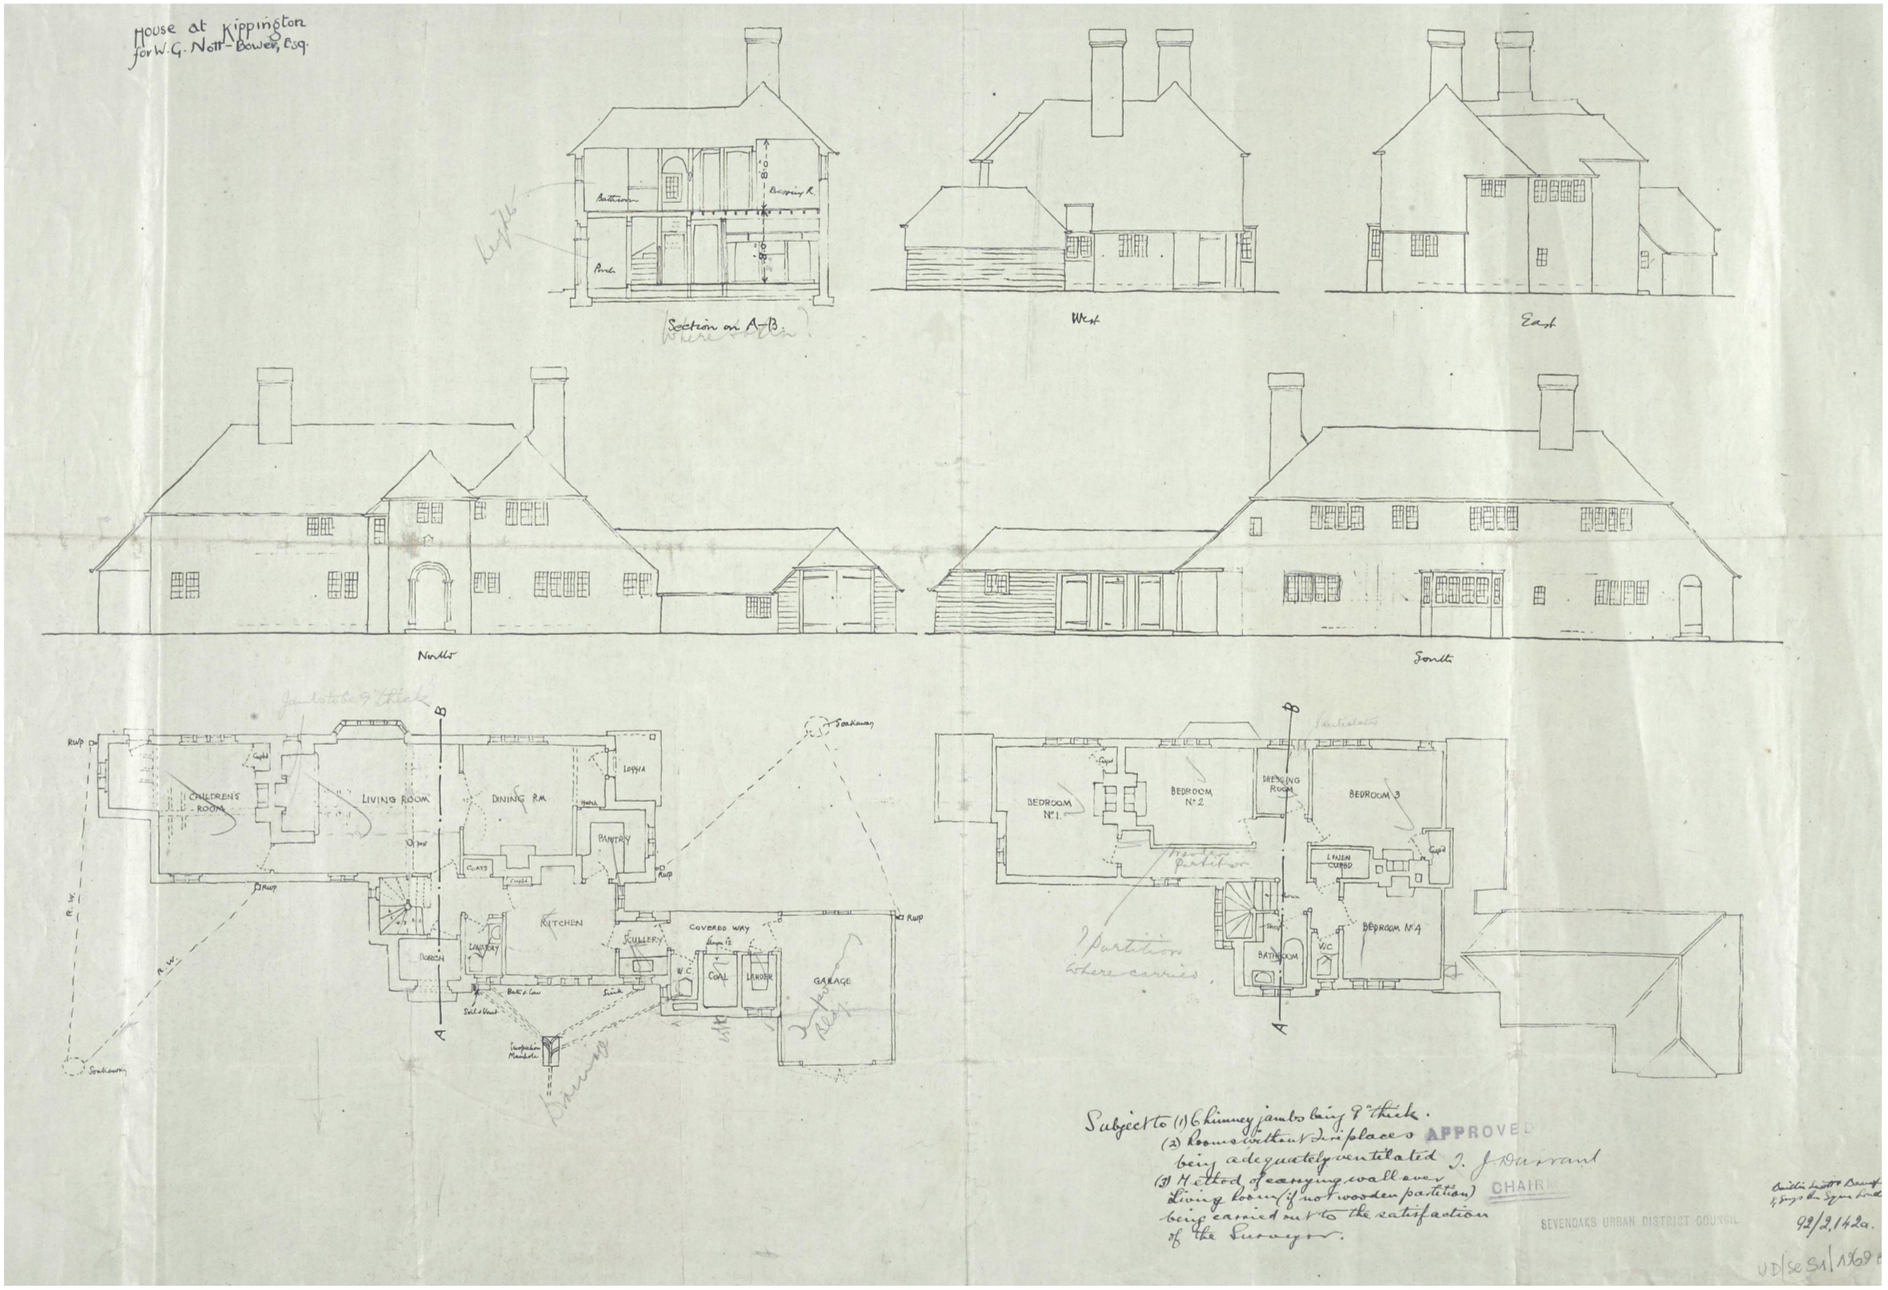

Record drawing approximately 1/200 scale

all designs and drawings © jhdarchitects

Drawing Status: Sketch Design
Print @ A3 Landscape
Monday, 19 April 2021
Not To Scale:

Historic Plans
Original Drawing
300-C-1

JHD Architects