Planting Schedule for CSA/2047/134-138

Fruit Tree - MM106 Rootstock

Qty	Name	Age	Height	Form	Girth	Ht/Stm	Brks	Root	Cntr	Measure Unit	Density (m2/lin m)	Centres
6	Malus 'Cox's Orange Pippin'		150-200cm	Half Standard				BR		nr		
6	Malus 'Discovery'		150-200cm					RB		nr		
12												

Fruit Tree - Rootstock MM111

Qty	Name	Age	Height	Form	Girth	Ht/Stm	Brks	Root	Cntr	Measure Unit	Density (m2/lin m)	Centres
4	Malus domestica 'Sunset'			Half Standard						nr		
4												

Heathland Mix 1

Overseed bare ground under heathland thicket mix with Acid Grassland Mix; Germinal Seeds GB; RE11 Heath Scrubland (U13 Grassland) Mix. 2-3g/m2 or equal and approved.

Qty	Name	Age	Height	Form	Girth	Ht/Stm	Brks	Root	Cntr	Measure Unit	Density (m2/lin m)	Centres
282	Calluna vulgaris		30-40cm					C	2-3L	m2	3.00	0.600
161	Cytisus scoparius		40-60cm				7	C	3L	m2	3.00	0.600
201	Erica cinerea 'Alba Minor'		30-40cm					C	2L	m2	3.00	0.600
161	Ulex europaeus		30-40cm				5	C	3L	m2	3.00	0.600
805												

Native Hedgerow Mix

Hedges to consist of double staggered row at 300mm centres, rows 300mm apart, approx. 5 planters per linear metre
Hedges to be supported by 1m high post and galvanised wire fence (min. 3 wires) running through centre of hedge between rows

Qty	Name	Age	Height	Form	Girth	Ht/Stm	Brks	Root	Cntr	Measure Unit	Density (m2/lin m)	Centres
304	Cornus sanguinea	1+2	60-80cm				3	B		m	5.00	0.200
609	Corylus avellana	1+2	60-80cm				3	B		m	5.00	0.200
1217	Crataegus monogyna	1+1	80-100cm	Transplant (seed-raised)				B		m	5.00	0.200
304	Ligustrum vulgare	1+1	60-80cm				3	B		m	5.00	0.200
304	Prunus spinosa	1+1	80-100cm				3	B		m	5.00	0.200
304	Viburnum lantana	1+2	80-100cm				3	B		m	5.00	0.200
3042												

Shrub

Qty	Name	Age	Height	Form	Girth	Ht/Stm	Brks	Root	Cntr	Measure Unit	Density (m2/lin m)	Centres
303	Aucuba japonica 'Rozannie'		30-40cm				3	C	3L	m2	5.00	0.450
150	Berberis thunbergii 'Atropurpurea Nana'		15-20cm	Bush			4	C	3L	m2	5.00	0.450
222	Brachyglottis 'Sunshine'		30-40cm				3	C	3L	m2	5.00	0.450
158	Ceanothus 'Blue Mound'		30-40cm (D)	Bushy			3	C	3L	m2	5.00	0.450
213	Choisya 'Aztec Pearl'		30-40cm	Bushy			5	C	3L	m2	5.00	0.450
273	Cistus pulverulentus 'Sunset'		30-40cm					C	3L	m2	5.00	0.450
179	Elaeagnus x ebbingei 'Limelight'		40-60cm	Bush			3	C	3L	m2	4.00	0.500
159	Escallonia 'Apple Blossom'		40-60cm	Bush			4	C	3L	m2	4.00	0.500
143	Escallonia 'Red Elf'		40-60cm	Bushy			4	C	3L	m2	4.00	0.500
172	Euonymus fortunei 'Blondy'	2x	20-30cm (D)	Bushy			6	C	3L	m2	5.00	0.450
296	Euonymus fortunei 'Darts Blanket'		30-40cm (D)				5	C	3L	m2	5.00	0.450
151	Griselinia littoralis 'Variegata'		30-40cm					C	3L	m2	5.00	0.450
293	Hebe 'Mette'	2x	30-40cm	Bushy			4	C	3L	m2	5.00	0.450
345	Hebe 'Pascal'	1+1 or 1/1	30-40cm	Bush			3	C	3L	m2	5.00	0.450
199	Hypericum 'Hidcote'		20-30cm (D)	Bushy			5	C	3L	m2	5.00	0.450
327	Ilex crenata 'Convexa'	2x	20-30cm (D)	Bush			3	C	3L	m2	5.00	0.450
343	Lavandula intermedia 'Grosso'	2x	15-20cm (D)	Bushy			5	C	3L	m2	5.00	0.450
242	Lonicera nitida 'Lemon Beauty'		30-40cm	Bushy			5	C	3L	m2	5.00	0.450
202	Mahonia aquifolium 'Apollo'		20-30cm	Bush			3	C	3L	m2	5.00	0.450
202	Osmanthus burkwoodii		30-40cm				4	C	3L	m2	4.00	0.500
189	Philadelphus 'Manteau d'Hermine'		30-40cm				3	C	3L	m2	5.00	0.450
158	Phlomis fruticosa		30-40cm	Bush			4	C	3L	m2	4.00	0.500
180	Photinia x fraseri 'Red Robin'	2x	30-40cm				3	C	3L	m2	4.00	0.500
215	Prunus laurocerasus 'Zabeliana'		20-30cm (D)				3	C	3L	m2	4.00	0.500
272	Santolina chamaecyparissus		20-30cm				7	C	3L	m2	5.00	0.450
155	Skimmia confusa 'Kew Green'		30-40cm (D)	Bushy			3	C	3L	m2	5.00	0.450
164	Spiraea japonica 'Goldflame'		30-40cm	Bushy			5	C	3L	m2	4.00	0.500
321	Viburnum davidii		25-30cm (D)				3	C	3L	m2	5.00	0.450
206	Viburnum opulus 'Compactum'	1+1	30-40cm	Bush			4	C	3L	m2	5.00	0.450
117	Weigela florida 'Variegata'		30-40cm	Bush			5	C	3L	m2	5.00	0.450
6355												

Shrub - Climber

All climbing shrubs to be supported by a minimum 1.5m tall timber trellis panel

Qty	Name	Age	Height	Form	Girth	Ht/Stm	Brks	Root	Cntr	Measure Unit	Density (m2/lin m)	Centres
2	Hedera helix 'Hibernica'		80-100cm				5	C	5L	nr		
9	Hydrangea anomala petiolaris		60-80cm				3	C	5L	nr		
11												

Shrub - Hedgerow

Hedges to consist of double staggered row at 300mm centres, rows 300mm apart, approx. 5 planters per linear metre
Hedges to be supported by 1m high post and galvanised wire fence (min. 3 wires) running through centre of hedge between rows

Qty	Name	Age	Height	Form	Girth	Ht/Stm	Brks	Root	Cntr	Measure Unit	Density (m2/lin m)	Centres
2024	Carpinus betulus (Hedge)	1+1	80-100cm	Bushy				B		m	5.00	0.200
3618	Prunus laurocerasus 'Etna' (Hedge)		40-60cm	Bushy			5	C	5L	m	5.00	0.200
5642												

Shrub - Rose

Qty	Name	Age	Height	Form	Girth	Ht/Stm	Brks	Root	Cntr	Measure Unit	Density (m2/lin m)	Centres
80	Rosa 'Iceberg'	1+0	30-40cm	Bushy			3	B		m2	5.00	0.450
80												

Shrub Mix - Structural 3

Shrub mix to to planted in single species groups of between 4 and 10 plants

Qty	Name	Age	Height	Form	Girth	Ht/Stm	Brks	Root	Cntr	Measure Unit	Density (m2/lin m)	Centres
22	Aucuba japonica 'Rozannie'		30-40cm				3	C	3L	m2	5.00	0.450
22	Brachyglottis 'Sunshine'		30-40cm				3	C	3L	m2	5.00	0.450
18	Lonicera nitida 'Maigreen'		30-40cm				6	C	3L	m2	4.00	0.500
22	Lonicera pileata		30-40cm	Bushy			5	C	3L	m2	5.00	0.450
18	Prunus laurocerasus 'Otto Luyken'		30-40cm				3	C	3L	m2	4.00	0.500
102												

Tree

Qty	Name	Age	Height	Form	Girth	Ht/Stm	Brks	Root	Cntr	Measure Unit	Density (m2/lin m)	Centres
2	Acer campestre		425-600cm	Standard (extra-heavy)	14-16cm			RB		nr		
16	Acer campestre	2x	300-350cm	Standard (Selected)	10-12cm	Min 200cm	4	RB		nr		
8	Acer campestre 'Queen Elizabeth'	3x	425-600cm	Extra-heavy (Standard)	14-16cm	min 200cm	7	RB		nr		
5	Alnus glutinosa	2x	300-350cm	Standard	10-12cm	Min 200cm	4	RB		nr		
9	Amelanchier arborea 'Robin Hill'	2x	300-350cm	Selected Standard	10-12cm	Min 200cm	5	B		nr		
4	Betula pubescens	2x	300-350cm	Standard (Selected)	10-12cm	175-200cm	4	RB		nr		
2	Carpinus betulus	2x	300-350cm	Standard	10-12cm	175-200cm	4	RB		nr		
2	Carpinus betulus	3x	425-600cm	Standard (Extra Heavy)	14-16cm	175-200cm	5	RB		nr		
5	Crataegus laevigata 'Paul's Scarlet'	2x	300-350cm	Standard (Selected)	10-12cm	175-200cm	4	B		nr		
3	Fagus sylvatica	2x	300-350cm	Standard	10-12cm	175-200cm	4	RB		nr		
2	Liriodendron tulipifera	4x	450-625cm	Standard (Semi-mature)	30-35cm	Min 350cm	8	RB		nr		
1	Liriodendron tulipifera 'Fastigiatum'	3x	425-600cm	Standard (extra-heavy)	14-16cm	175-200cm	5	RB		nr		
10	Prunus avium	2x	250-300cm	Standard	10-12cm	150-175cm	5	RB		nr		
5	Prunus avium 'Plena'	3x	425-600cm	Standard (extra-heavy)	14-16cm	175-200cm	4	RB		nr		
1	Prunus padus	2x	300-350cm	Standard	10-12cm	175-200cm	4	RB		nr		
6	Prunus padus	3x	425-600cm	Standard (extra-heavy)	14-16cm		7	RB		nr		
2	Pyrus calleryana 'Chanticleer'	2x	300-350cm	Standard	10-12cm	175-200cm		RB		nr		
3	Quercus robur	2x	250-300cm	Standard	10-12cm		4	RB		nr		
4	Robinia pseudoacacia 'Bessoniana'	2x	300-350cm	Standard (Selected)	10-12cm	175-200cm	4	B		nr		
13	Sorbus aria 'Majestica'		300-350cm	Standard	10-12cm	175-200cm	3	RB		nr		
1	Sorbus aucuparia 'Cardinal Royal'	2x	300-350cm	Standard (Selected)	10-12cm	175-200cm	4	RB		nr		
104												
1638												

NB:- Species Rich Native Hedgerow Mix (Trough Grown) is to be supplied by 'best4hedging', or equal and approved. Provided in 1m lengths. Contains 10 different species, of which 8 can be guaranteed to appear in every 6m of hedging. Contains a range of wildflowers within the mix as an understorey, which will be fully knitted together with the hedge itself.

NOTE: FRUIT TREES TO SOUTHERN BOUNDARY
All trees denoted FRUIT T to be chosen from list of suitable specimens and stock types/sizes supplied by TDC

REVISIONS

ORIGINAL LANDSCAPE PROPOSALS SHOWN ON CSA DRAWINGS CSA/2047/134-138

SCALE 1:250 (Meters to cm)

0 2.5 5 10 15 20

0 1.0cm 2.0cm 4.0cm 6.0cm 8.0cm

NORTH

NOTE: THIS DRAWING IS "AS BUILT" BY OTHERS. WITH AMENDMENTS FOLLOWING TWH MEETING WITH TDC/ ALRESFORD PARISH COUNCIL. THIS REPLACES CSA HARD/SOFT LANDSCAPE DRAWINGS FOR POS AREAS ONLY

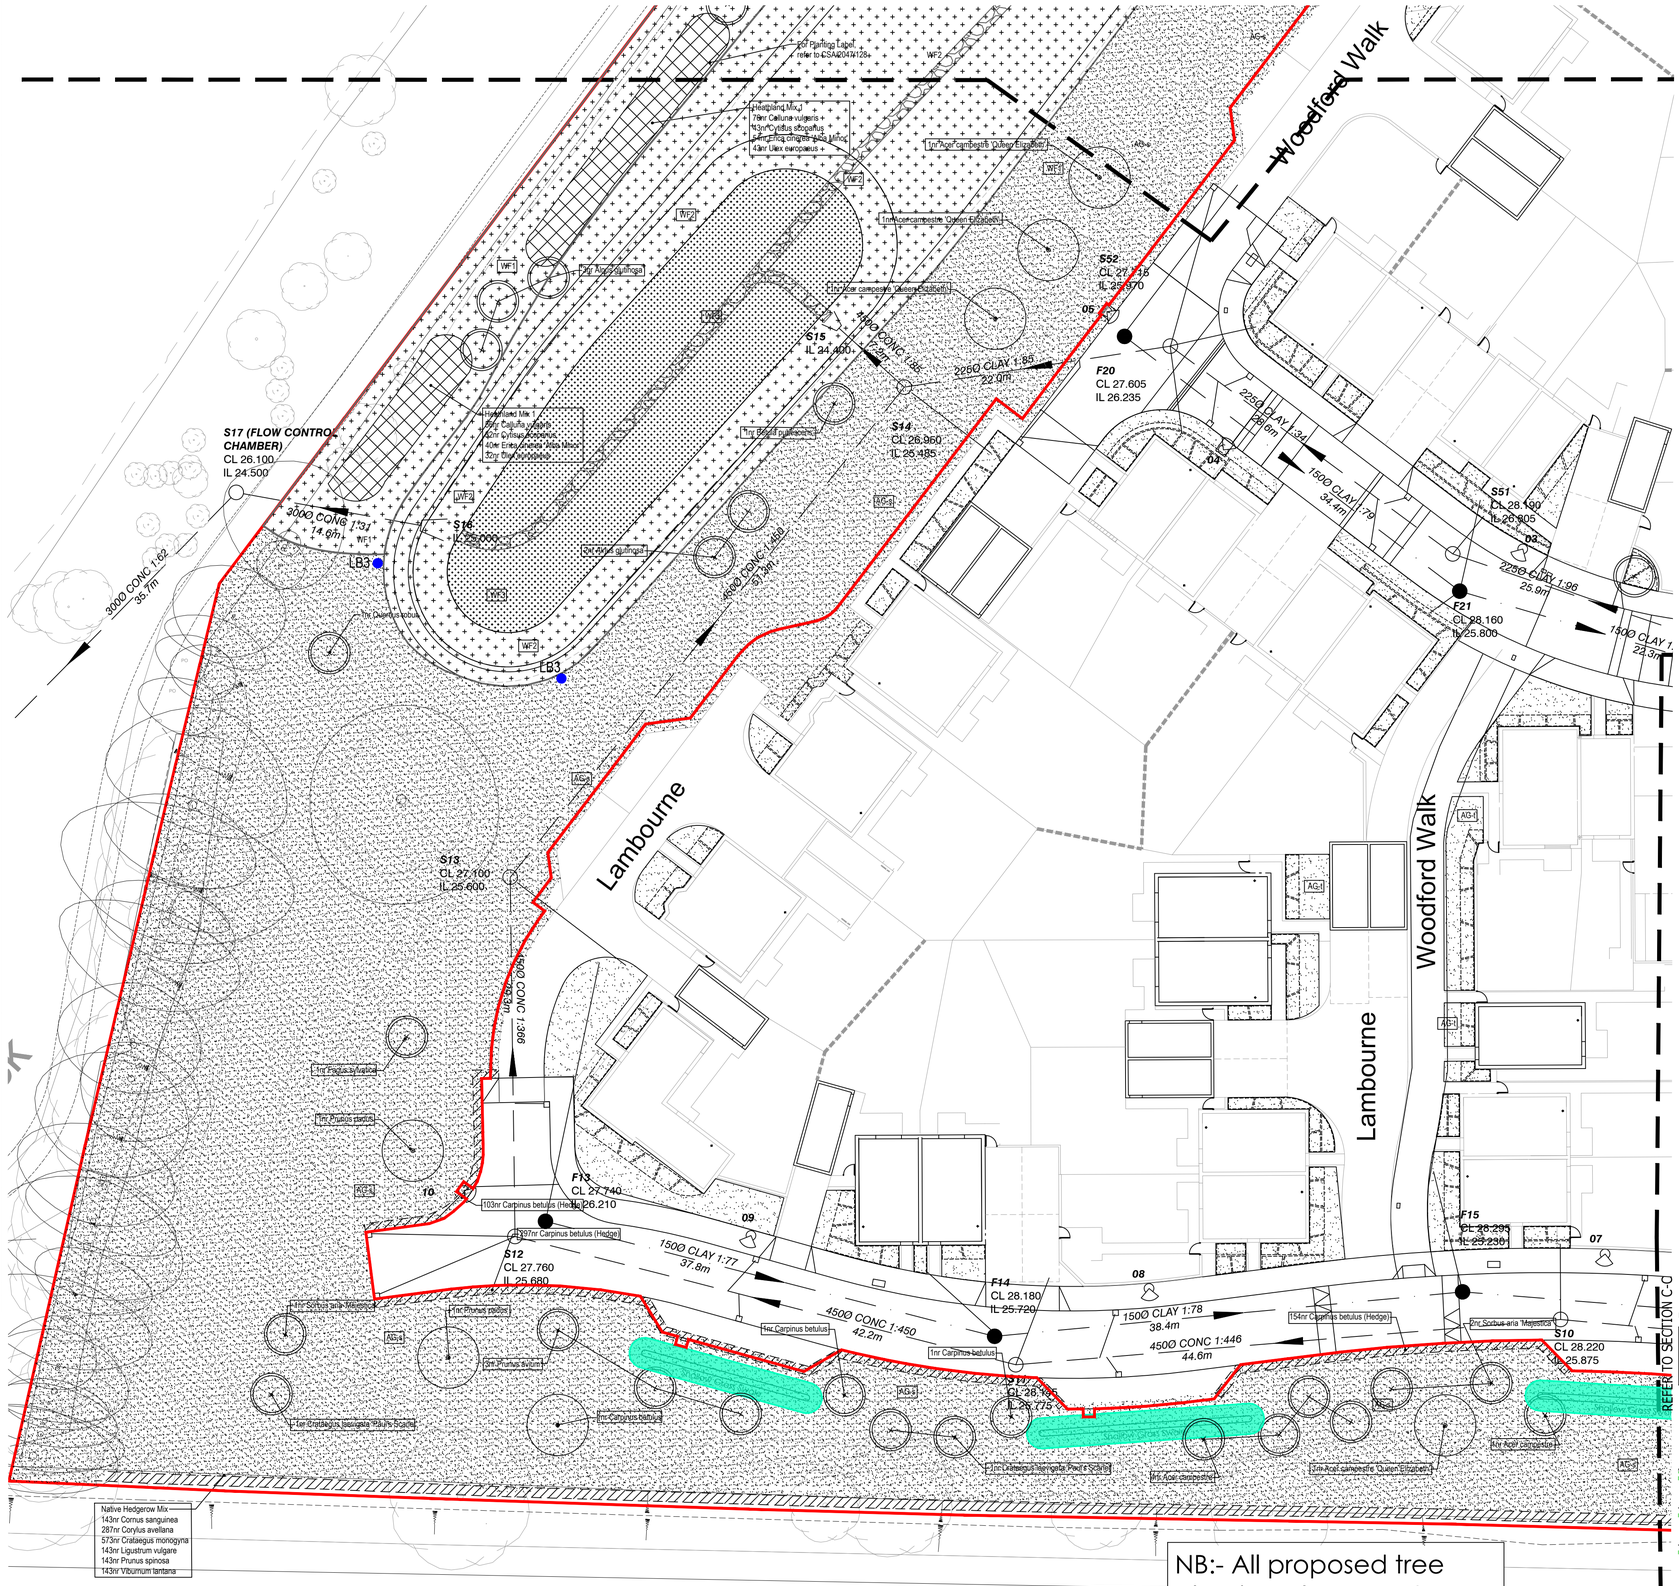
Woodford Walk
Lambourne
For Planting Label refer to CSA/2047/128
Heathland Mix 1
78nr Calluna vulgaris +
42nr Cytisus scoparius +
54nr Erica cinerea 'Alba Minor' +
43nr Ulex europaeus +
1nr Acer campestre 'Queen Elizabeth'
1nr Acer campestre 'Queen Elizabeth'
1nr Acer campestre 'Queen Elizabeth'
