Survey stations				
SS no.	Eastings	Northings	Elevation	Description
1	1000.000	5000.000	100.000	NAIL
2	1014.009	5000.310	100.523	NAIL

North approximate.

Levels taken relative to site benchmark
located on: Stn 1 value 100.00m

GRASS LAWNS (Turfed)
Grass areas to be turfed with ready grown ROLAWN or similar. To approval depth of 200mm of fine textured premium topsoil to BS3882. Clean free draining subsoil cultivated and weed free prior to use

REAR PATIO

DRIVES AND PATHS
PERMEABLE PAVING

FOUL DRAIN RUN

SURFACE WATER DRAIN RUN

SOAKAWAY LOCATION
and roof drainage run

WATER BUTT 150L

B

EXISTING LEVELS IN BLUE INK

PROPOSED LEVELS IN RED INK

1800 750 BINS/RECYCLING

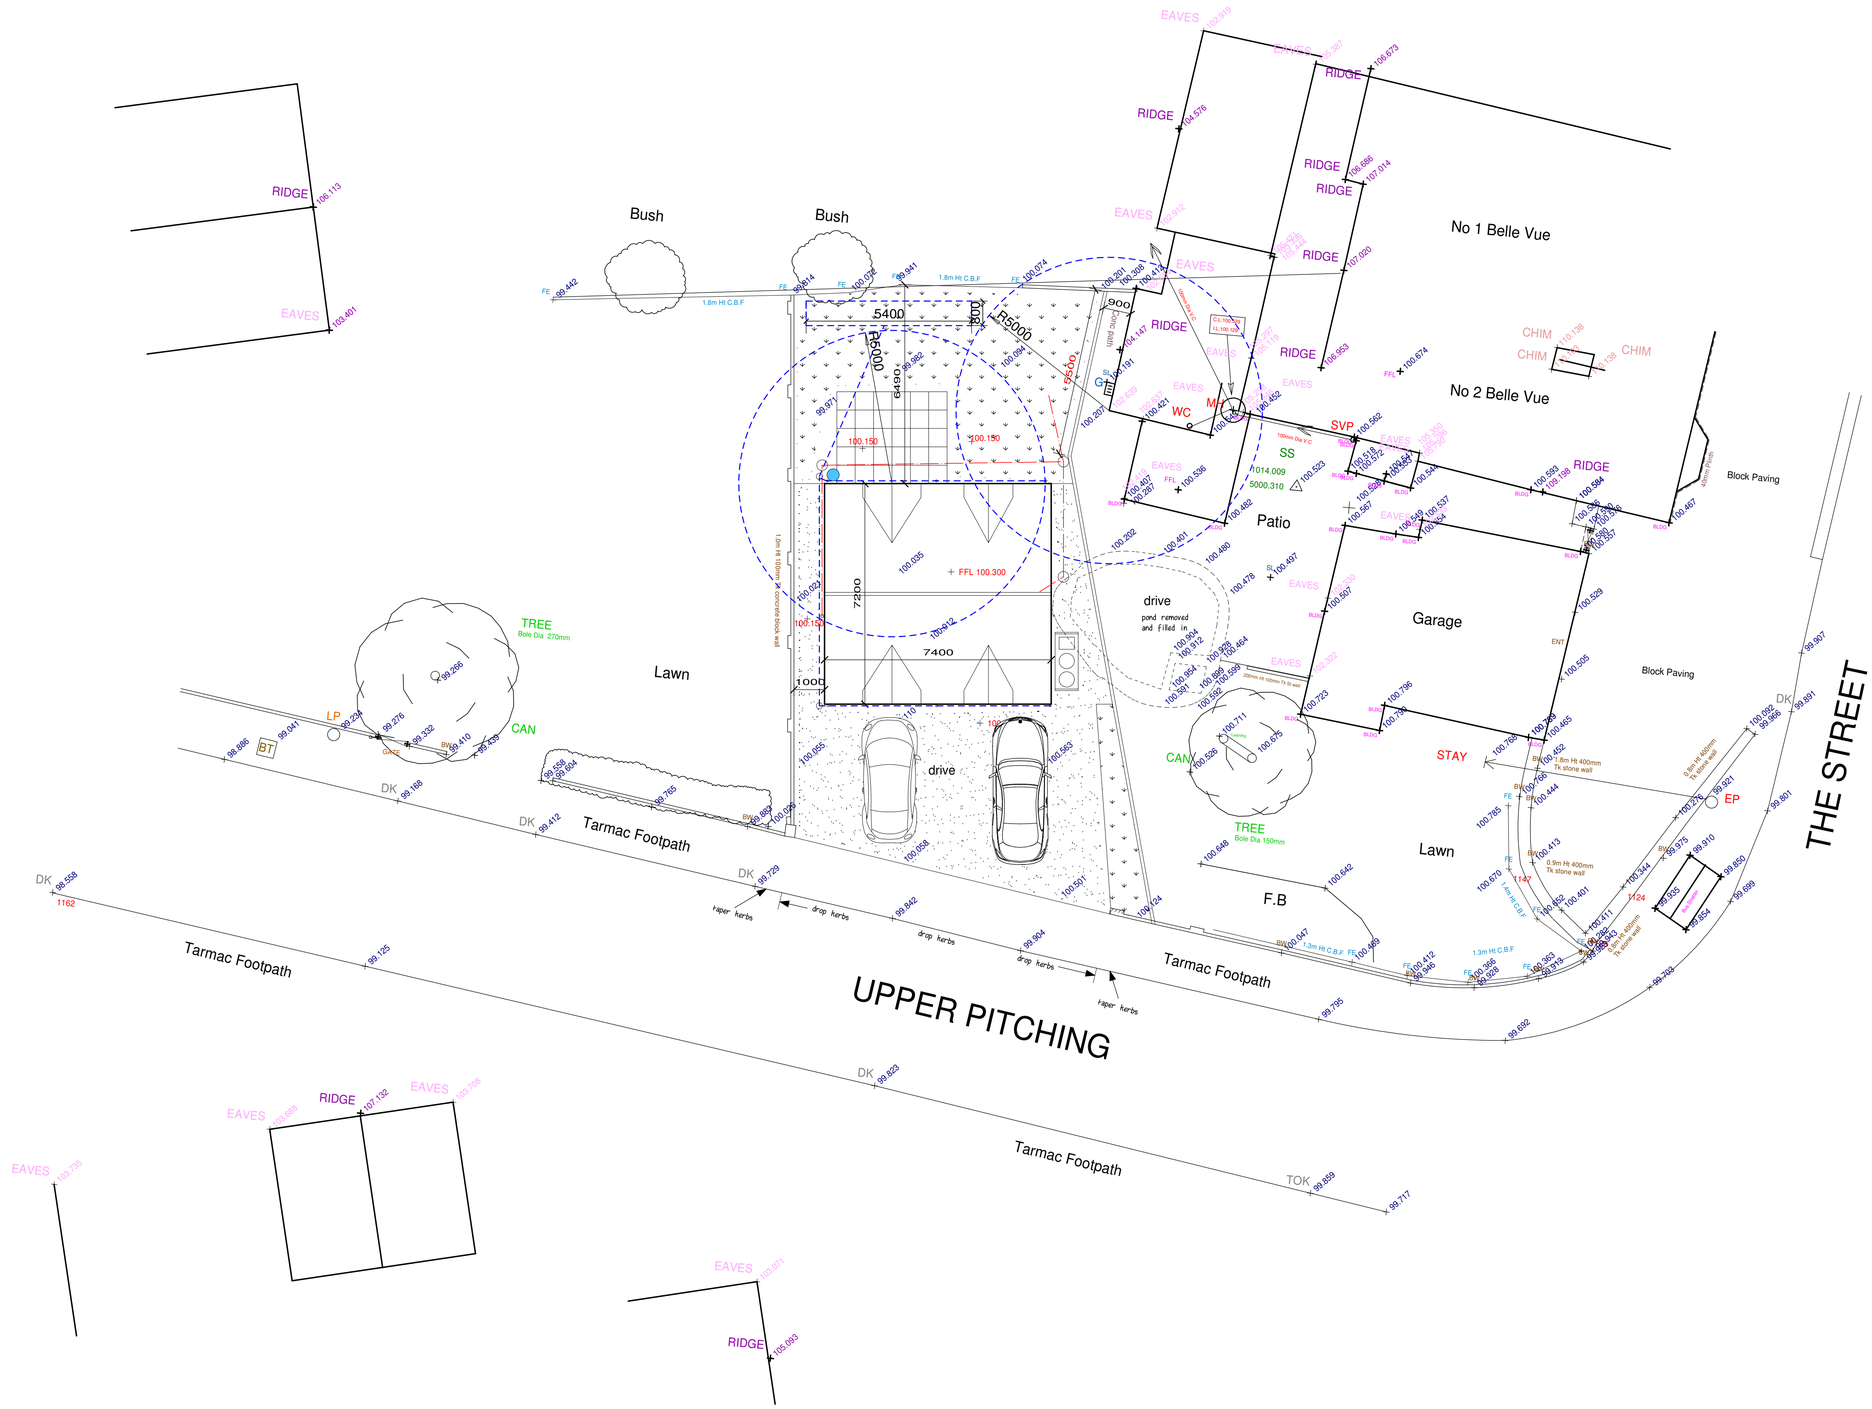

Rev	Date	Details	Ref
D	AUG 23	DRIVEWAY REVISED AS BUILT	
C	JUL 22	SOAKAWAY RESIZED TO BE MIN 5M FROM BUILDINGS	
B	OCT 20	BOUNDARY ALTERATION	
A	APR 20	DWELLING MIRRORED	

PROJECT:

Detached dwelling on land at
2 Belle Vue
The Street
Chilcompton
BA3 4HG

PROPOSED SITE PLAN

CLIENT: Mr M. Robbins

SCALE: 1:100 @ A1

DRAWING NO: 2020/BELLEVUE/01D

DATE: JAN 2020

DRAWN: m. bissex

LITTLEBROOK HOUSE
MEADOW VIEW
RADSTOCK
BA3 3QT
Tel: 01761436861
www.mbad.co.uk
mbissex@mbad.co.uk

MATTHEW BISSEX
ARCHITECTURAL
DRAWINGS LTD