ALL DIMENSIONS TO BE CHECKED ON SITE AND ANY DISCREPANCIES AND ADJUSTMENTS TO BE NOTED AND PASSED TO THE CONTRACT ADMINISTRATOR FOR FURTHER INSTRUCTIONS. IF IN DOUBT ASK.

0 5M 10M 20M 40M

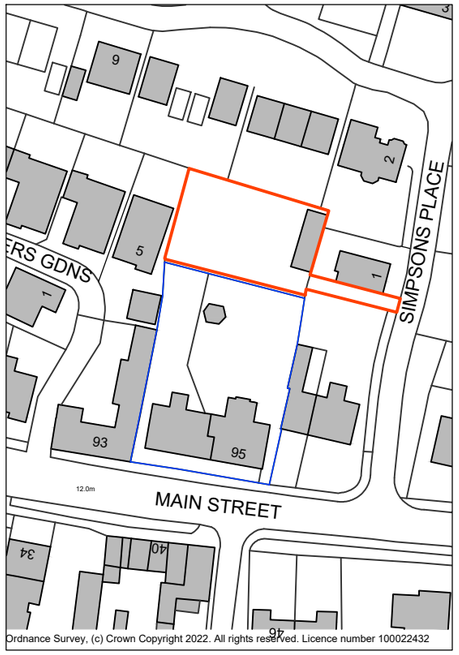

01 LOCATION PLAN
1:1250

0 1M 2M 4M 10M

NORTH

RIBA Chartered Practice

arb Architects Registration Board

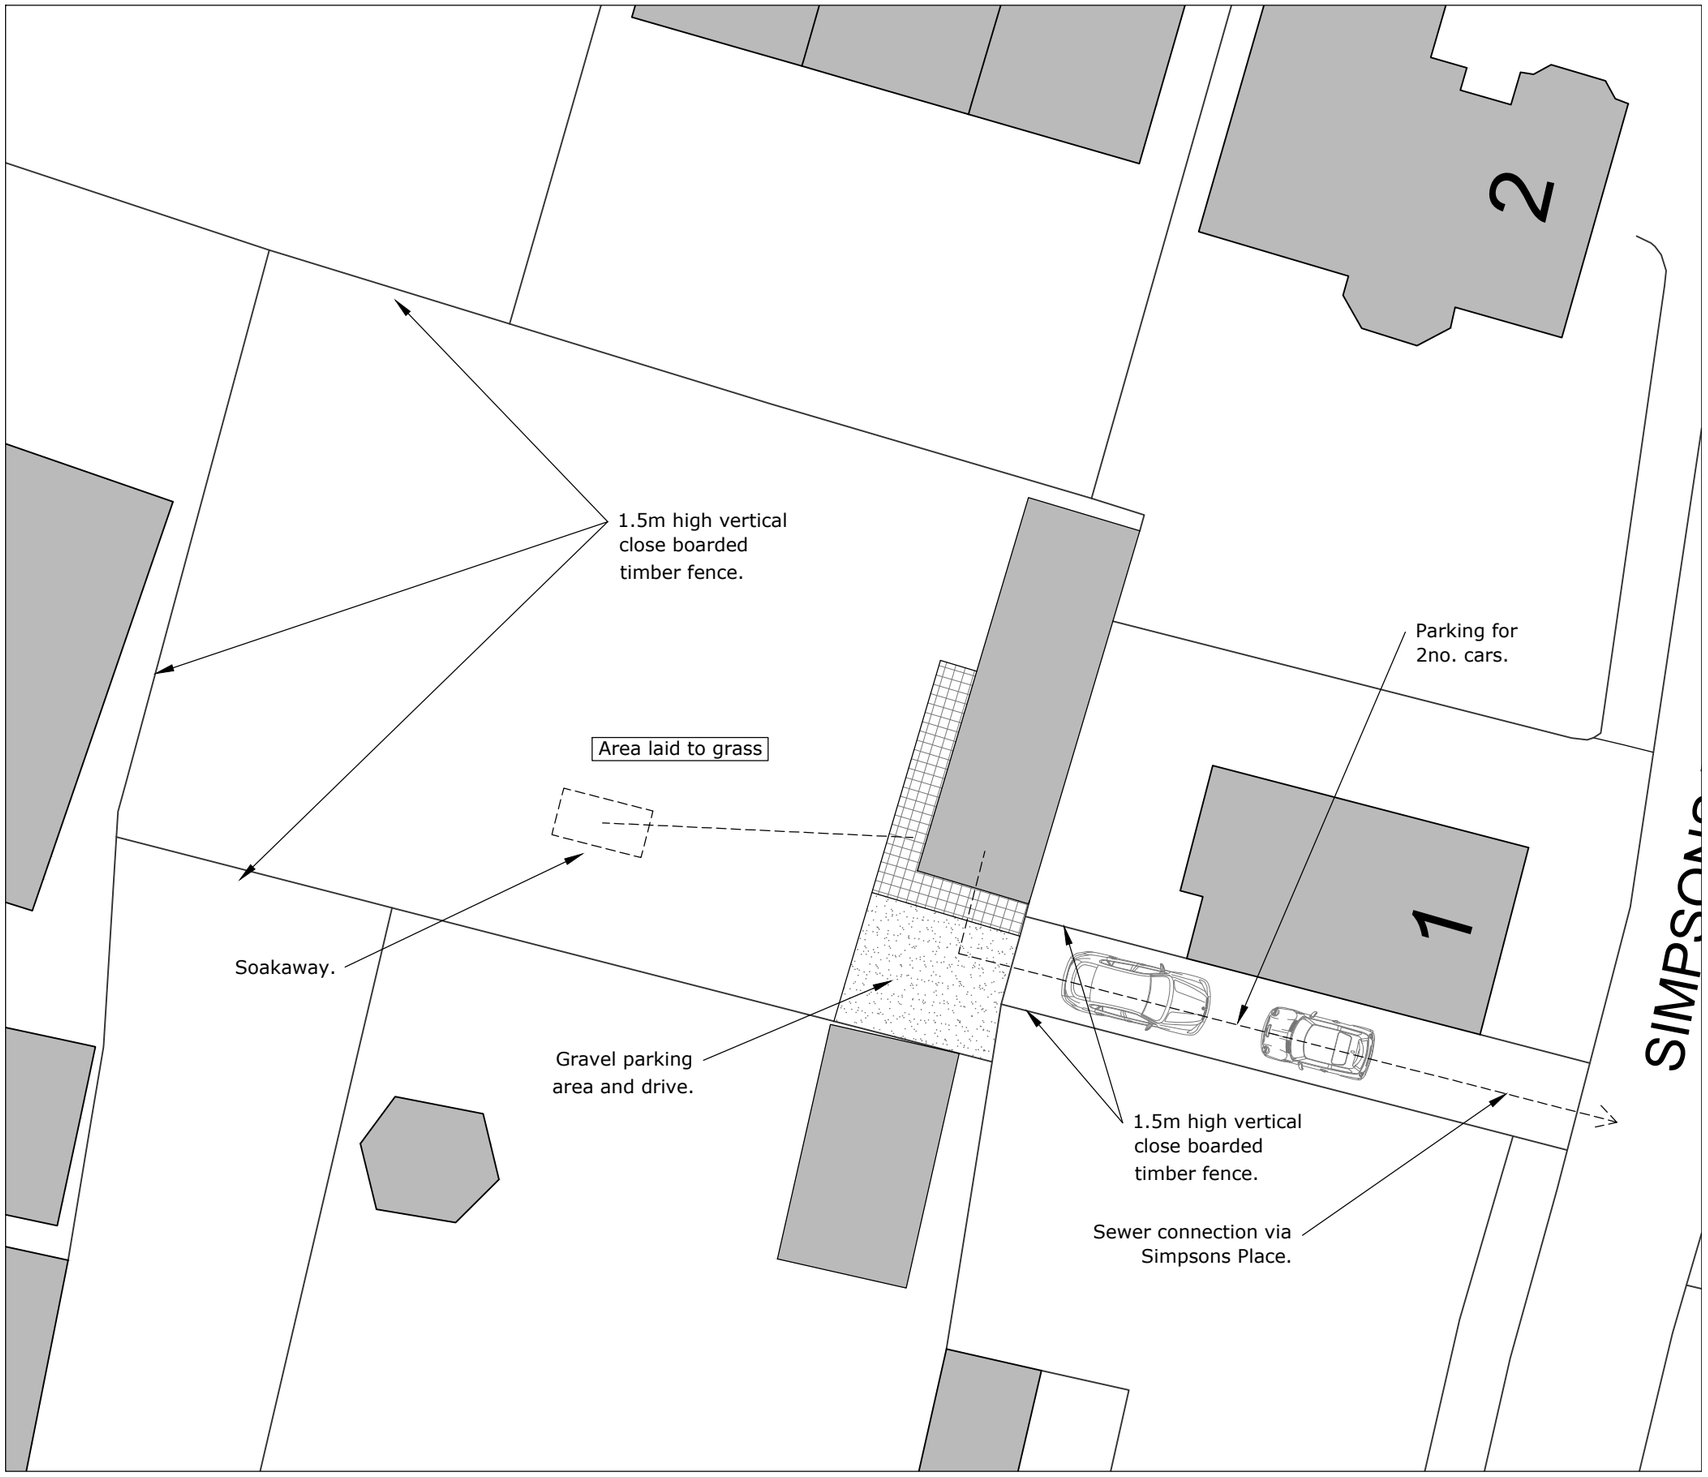

02 SITE PLAN (AS BUILT)
1:200

RobsonArchitecture

T 07815 955 011
E david@robsonarchitecture.co.uk
W www.robsonarchitecture.co.uk

ROBSON ARCHITECTURE
THE BUNGALOW, DRIFFIELD ROAD, WANSFORD, EAST YORKSHIRE, YO25 8NU

JOB TITLE: 95 MAIN STREET, CRANSWICK, EAST RIDING OF YORKSHIRE, YO25 9QY

CLIENT: N. SIMPSON

DWG TITLE: LOCATION PLAN AND AS BUILT SITE PLAN

SCALE	DATE	CHECK	DRAWN	DATE	REVISION	Rev.No.	REV.	DWG NO.
1:1250/1:200	AUG 23		DR				-	10506-01

© COPYRIGHT