



PROPOSED 1:1250 OS MAP

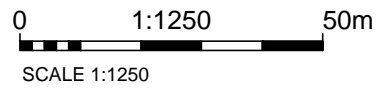


PROPOSED 1:200 SITE PLAN

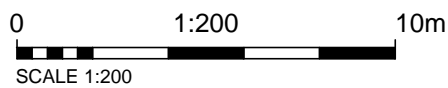

REVISIONS

No	Description	Date

Notes

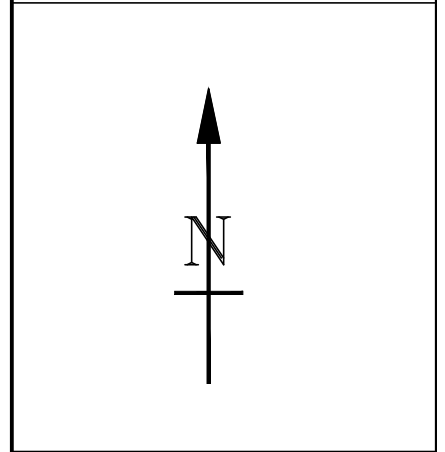

DRAWING STATUS

PLANNING

INSTRUCTION

This drawing is the property of ARISTA ARCHITECTURE and may not be reproduced without prior consent.
www.arista-architecture.com

Client ECOS PROPERTIES LTD

Project 127 EDRIDGE ROAD
CROYDON CR0 1EJ

Title AS BUILT SITE PLAN

Scale	1:200	Drawing No.	2203/010	Rev.	-
Date	07.11.23				