PARKING SPACE SCHEDULE			
TYPE	McDonald's	KFC	TOTAL
DDA SPACES	2	2	4
LARGE ORDER BAYS	2	2	4
STANDARD PARKING BAYS	24	22	46
OVERALL	**28**	**26**	**54**

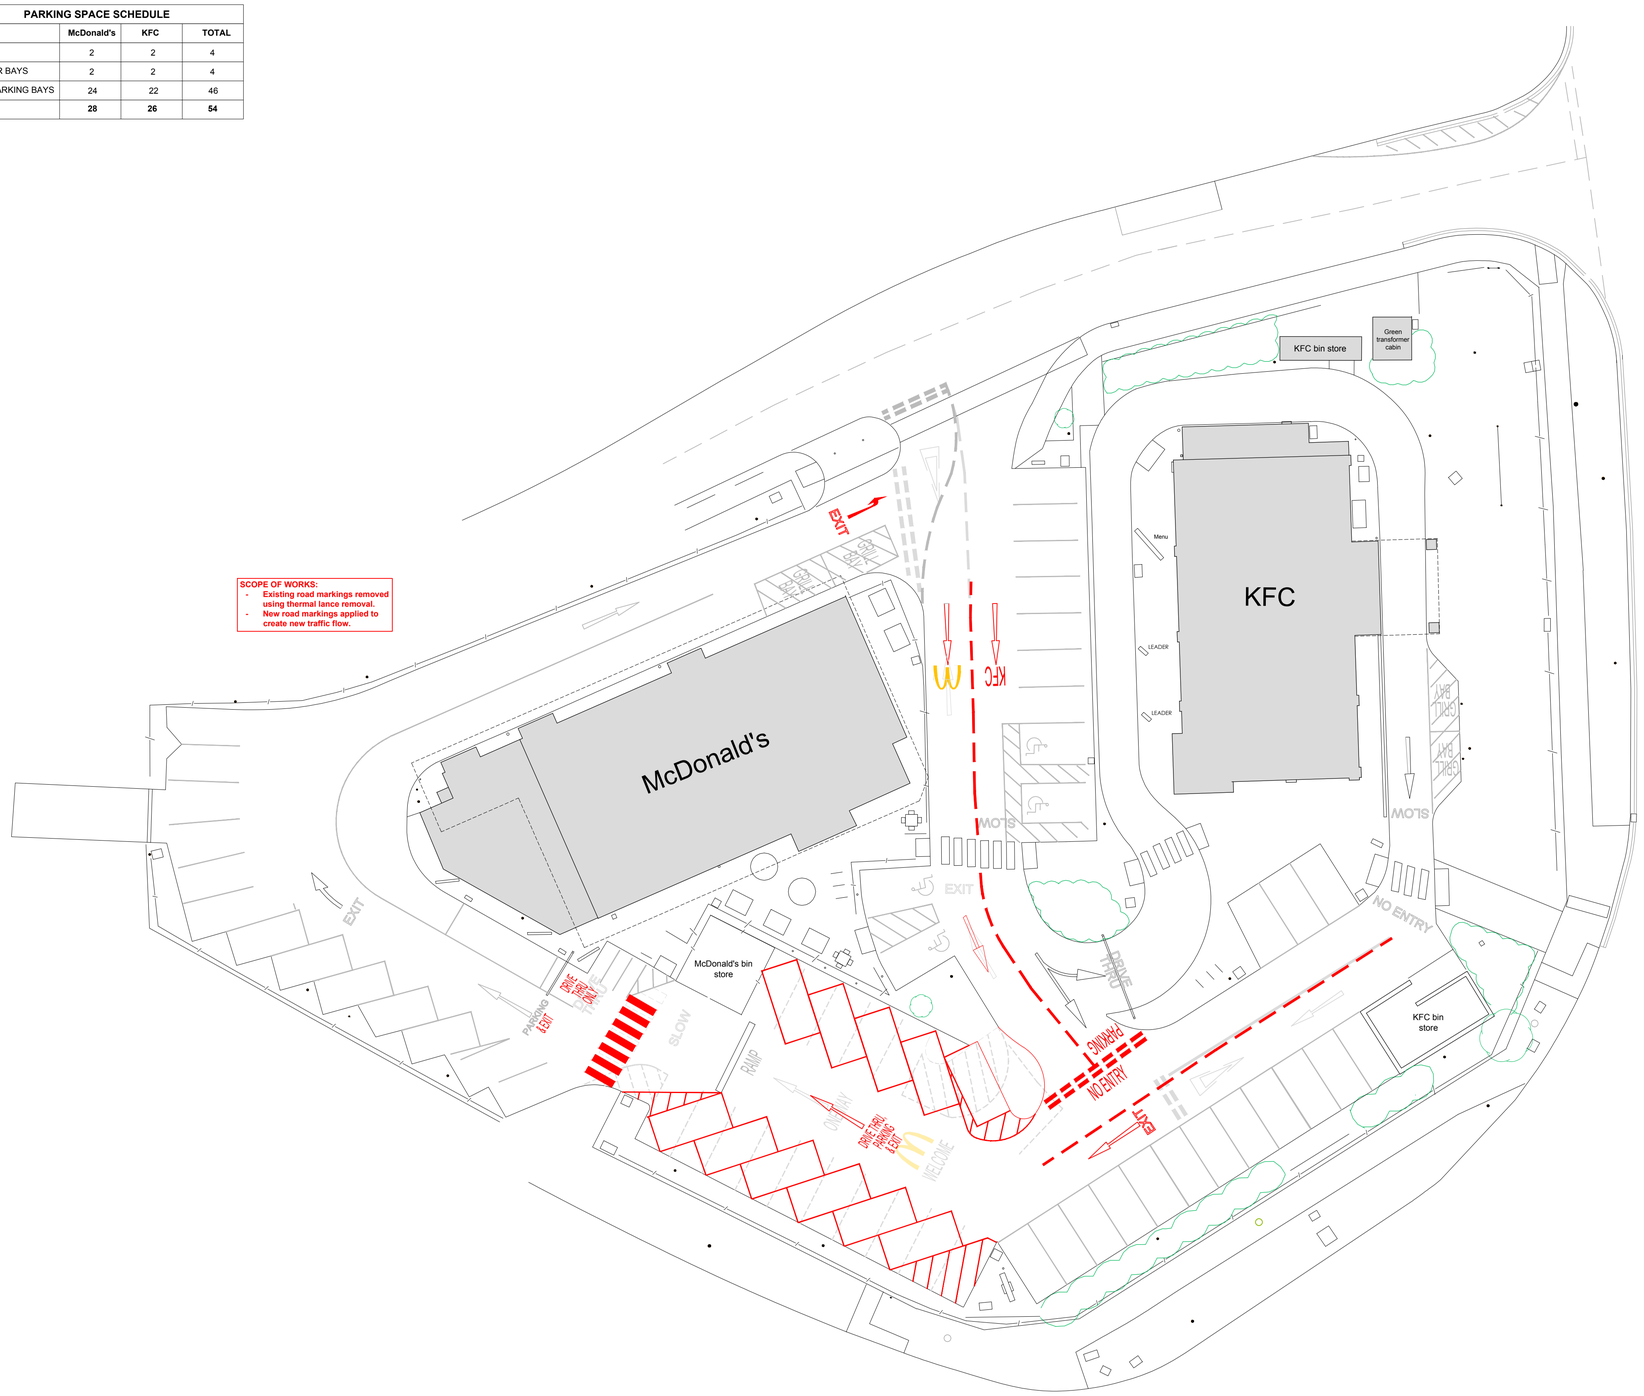

1:200

0 4m 8m 12m 16m 20m

N

ALL DIMENSIONS TO BE CHECKED ON SITE.

DO NOT SCALE FROM THIS DRAWING EXCEPT FOR THE PURPOSES OF LOCAL AUTHORITY PLANNING

DESIGN SIGNOFF	
Name	
Title	
Description	
Date	

rev	date	description
-	--	----
A	05/08/21	
B	24/02/22	Scope of works.
C	17/08/23	Plan amended in-line with survey and tracking information
D	21/08/23	
E	06/11/23	New kerbs and road markings shown in red & removed kerbs and road markings shown in light grey
F	06/11/23	Parking sapce schedule shown

ARCHITECTURAL DESIGN
Willows 1, Mill Farm Courtyard, Beachampton,
Milton Keynes, Buckinghamshire, MK19 6DS
T: 01525 240800
E: admin@aw-architectural.co.uk
W: www.aw-architectural.co.uk

KFC UK&I

SOUTHAMPTON

CAR PARK LAYOUT

store address
Millbrook Roundabout,
Millbrook,
Southampton
SO16 9SH

drawing title
PROPOSED SITE PLAN

drawn by	checked	date
DK	AW	July 2021
store no.	scale	
N/A	1:200 @ A1	

FOR PLANNING

drawing no.	revision
SHK21/SK121	F