SIDE ELEVATION (TO DARTMOUTH STREET)

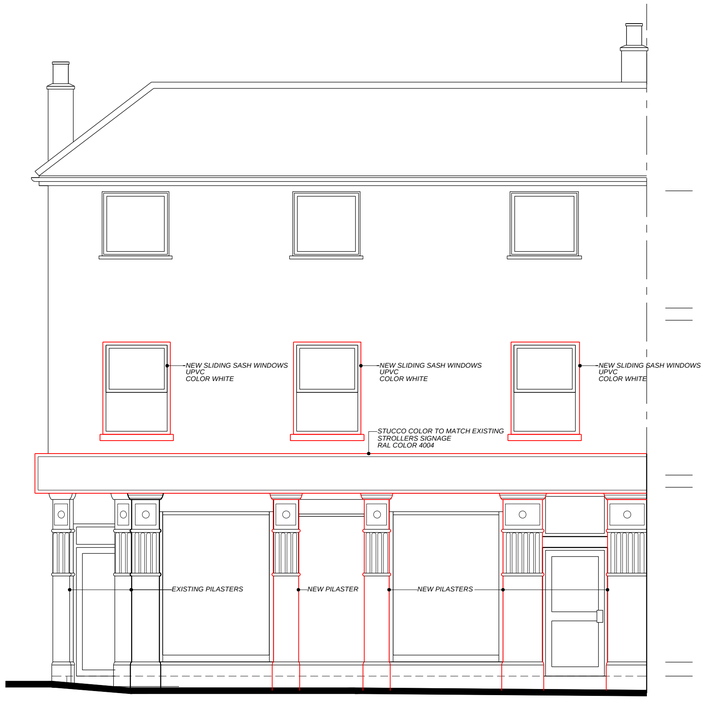

FRONT ELEVATION (TO HIGH STREET)

CURRENT BUILDING - AS BUILT

BUILDING PRIOR TO EXISTING ALTERATIONS

REV	DRAWN	
	DATE	

Sdb architecture
DESIGN, PLANNING & PROJECT MANAGEMENT
20 Bridgnorth Road, Wombourne, Staffs, WV5 0AA
[redacted]

PROJECT

PROPOSED EXTENSION & ALTERATIONS
376 HIGH STREET
WEST BROMWICH
B70 9LB

CLIENT

[redacted]

DRAWING

DISCHARGE OF CONDITIONS DETAILS

DRAWN	CHECKED	APPROVED
CAD.	SCALE 1/100@A1	DATE 14.03.23

DRAWING No. 2041/P100 REV A