AMENDMENTS:
A 27/02/23 AS BUILT AMENDMENTS
B 28/04/23 LANDSCAPING, SURFACE WATER DRAINAGE, A/C DETAILS ADDED
C 05/10/23 PROPOSED REAR CANOPY ADDED

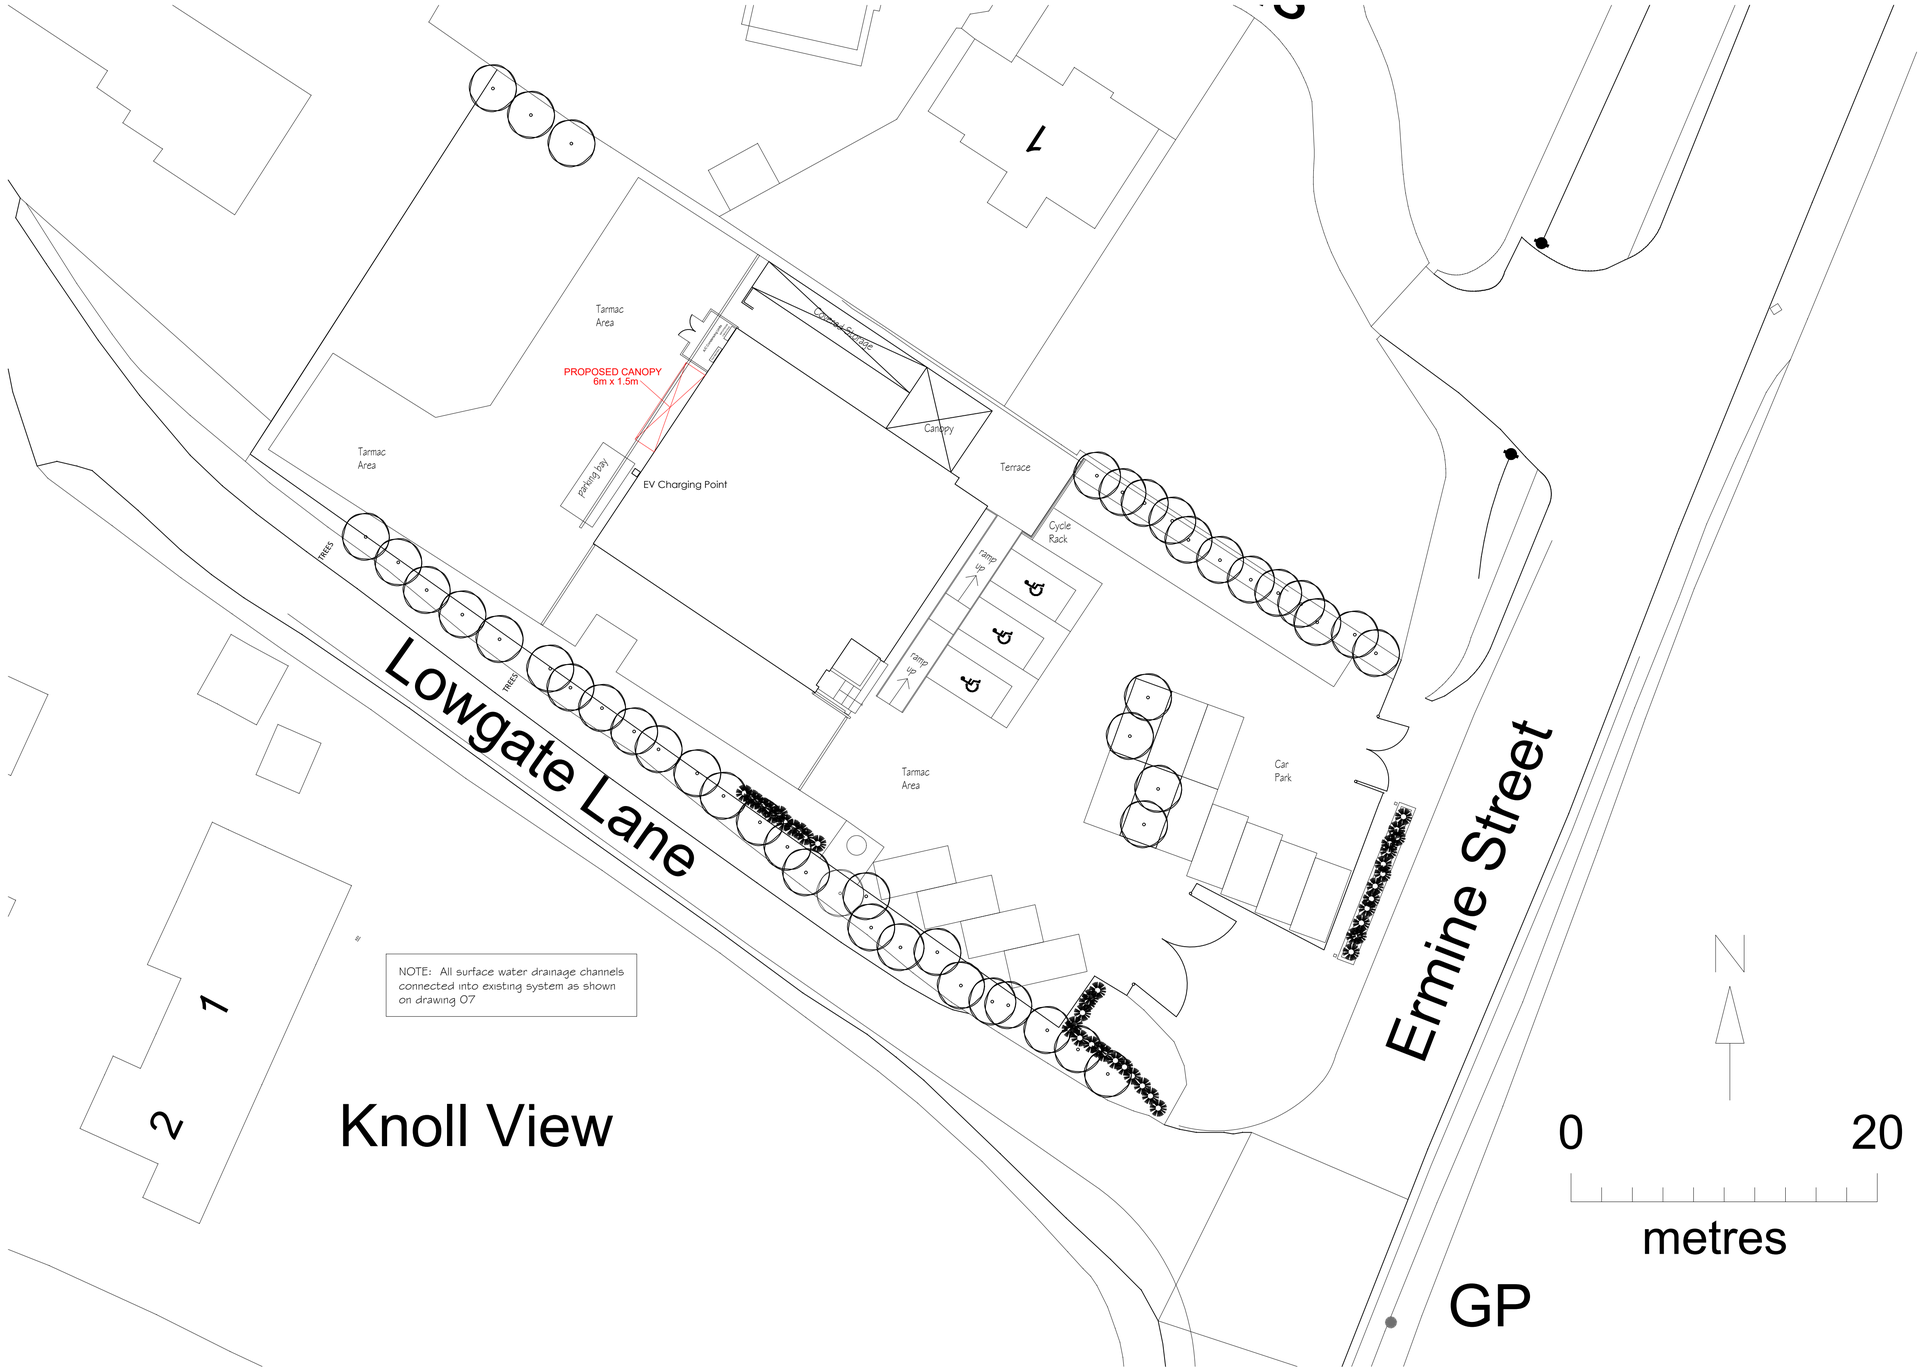

PROJECT:	DRAWING TITLE:	DRG. No.	SCALE:	PAPER SIZE:	DATE:
Raj Villa, Ermine Street, High Cross, Herts.	Block Plan As Proposed	JJD/2021-12/02C	1:200	A1	05/21

0 10 20 30 40 50 60 70 80 90 100mm

Chartered Institute of Architectural Technologists Registered Practice
JRT ARCHITECTURAL DESIGN LIMITED
25 Shorham Rise, Two Mile Ash, Milton Keynes, MK8 8BS T: 01908 261565 M: 07990 761527 E: info@jrtdesignltd.co.uk