PRUDENTIAL HOUSE, GROUND FLOOR

1:75@A1

0 5

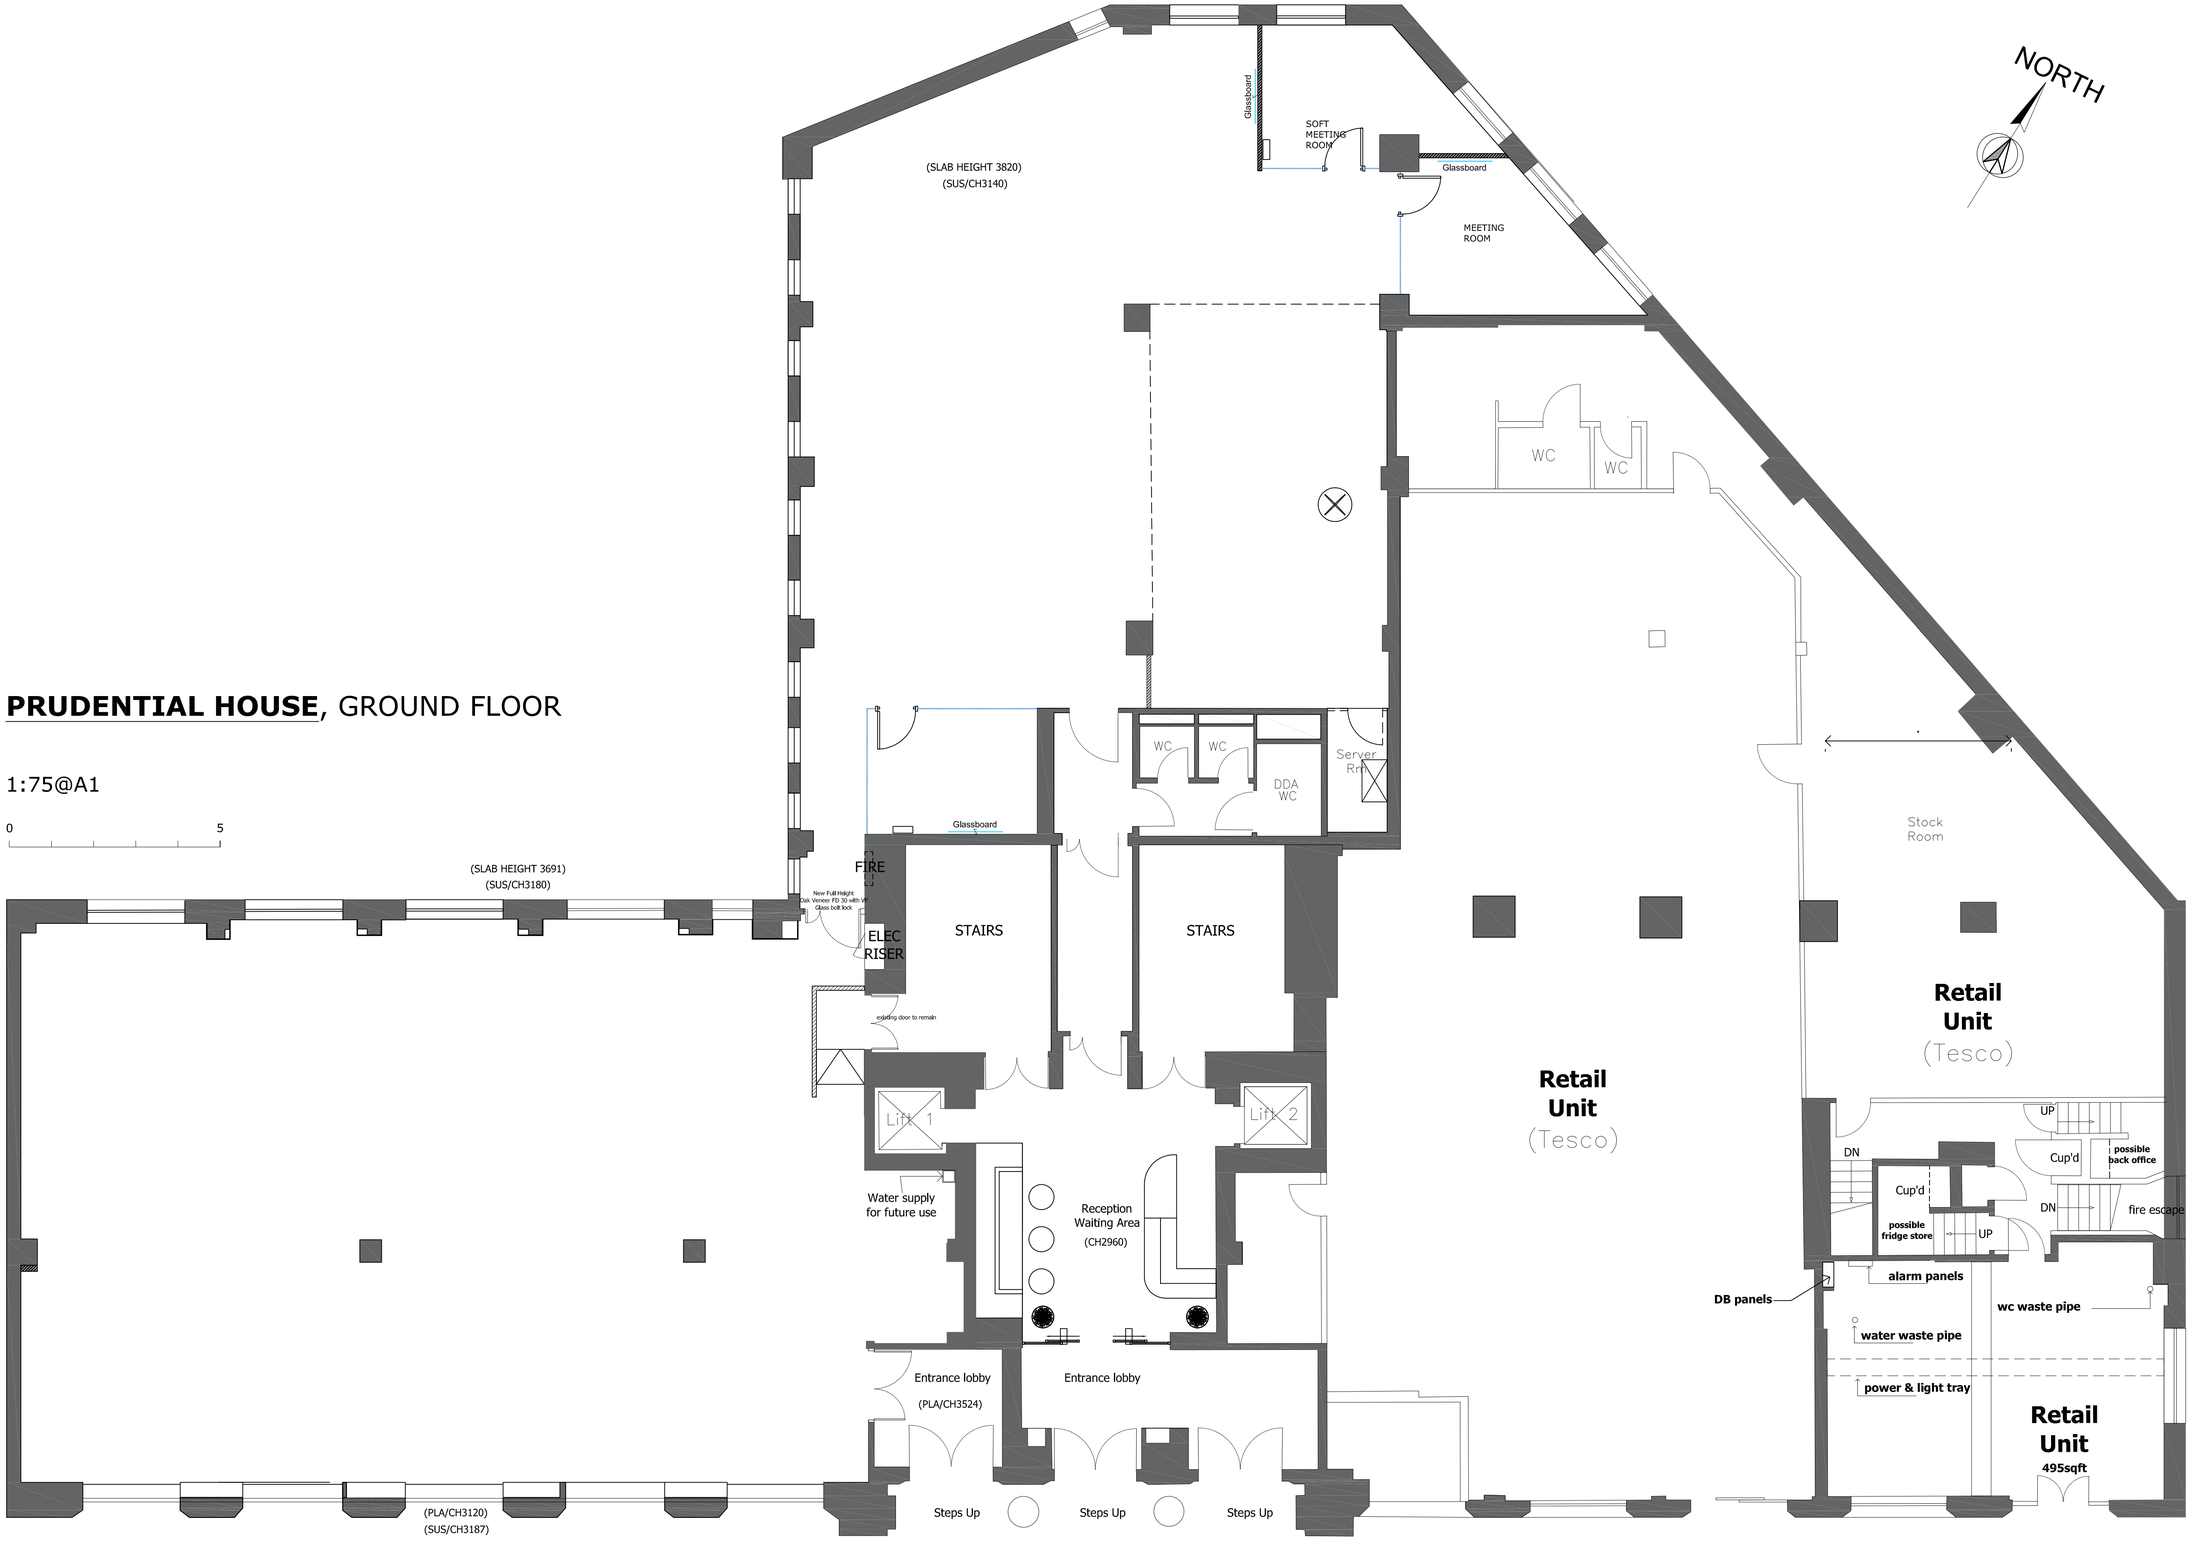

PRUDENTIAL BUILDING

AS BUILT LAYOUT

Ground Floor

1:100@A1

Do not scale off these drawings. All dimensions and details shown are to be checked on site and verified by the contractor.

Report any discrepancies to Concept4 Ltd.

NOTES:

CREATIVE WORKSPACE

Rev	Description	Date

concept4.

Concept4 Ltd, The Sanctuary
Eden Office Park, Macrae Road
Ham Green, Bristol BS20 0DD
T. 0845 1264444
concept4.co.uk

Client :	CONCEPT4	
Title :	AS BUILT	
	GROUND FLOOR LAYOUT	
	PRUDENTIAL HOUSE	
Date :	31.03.23	
Dwg Ref :	PSP01(00)	
Drawn by :	Rev :	Scale :
NR		1:75@A1