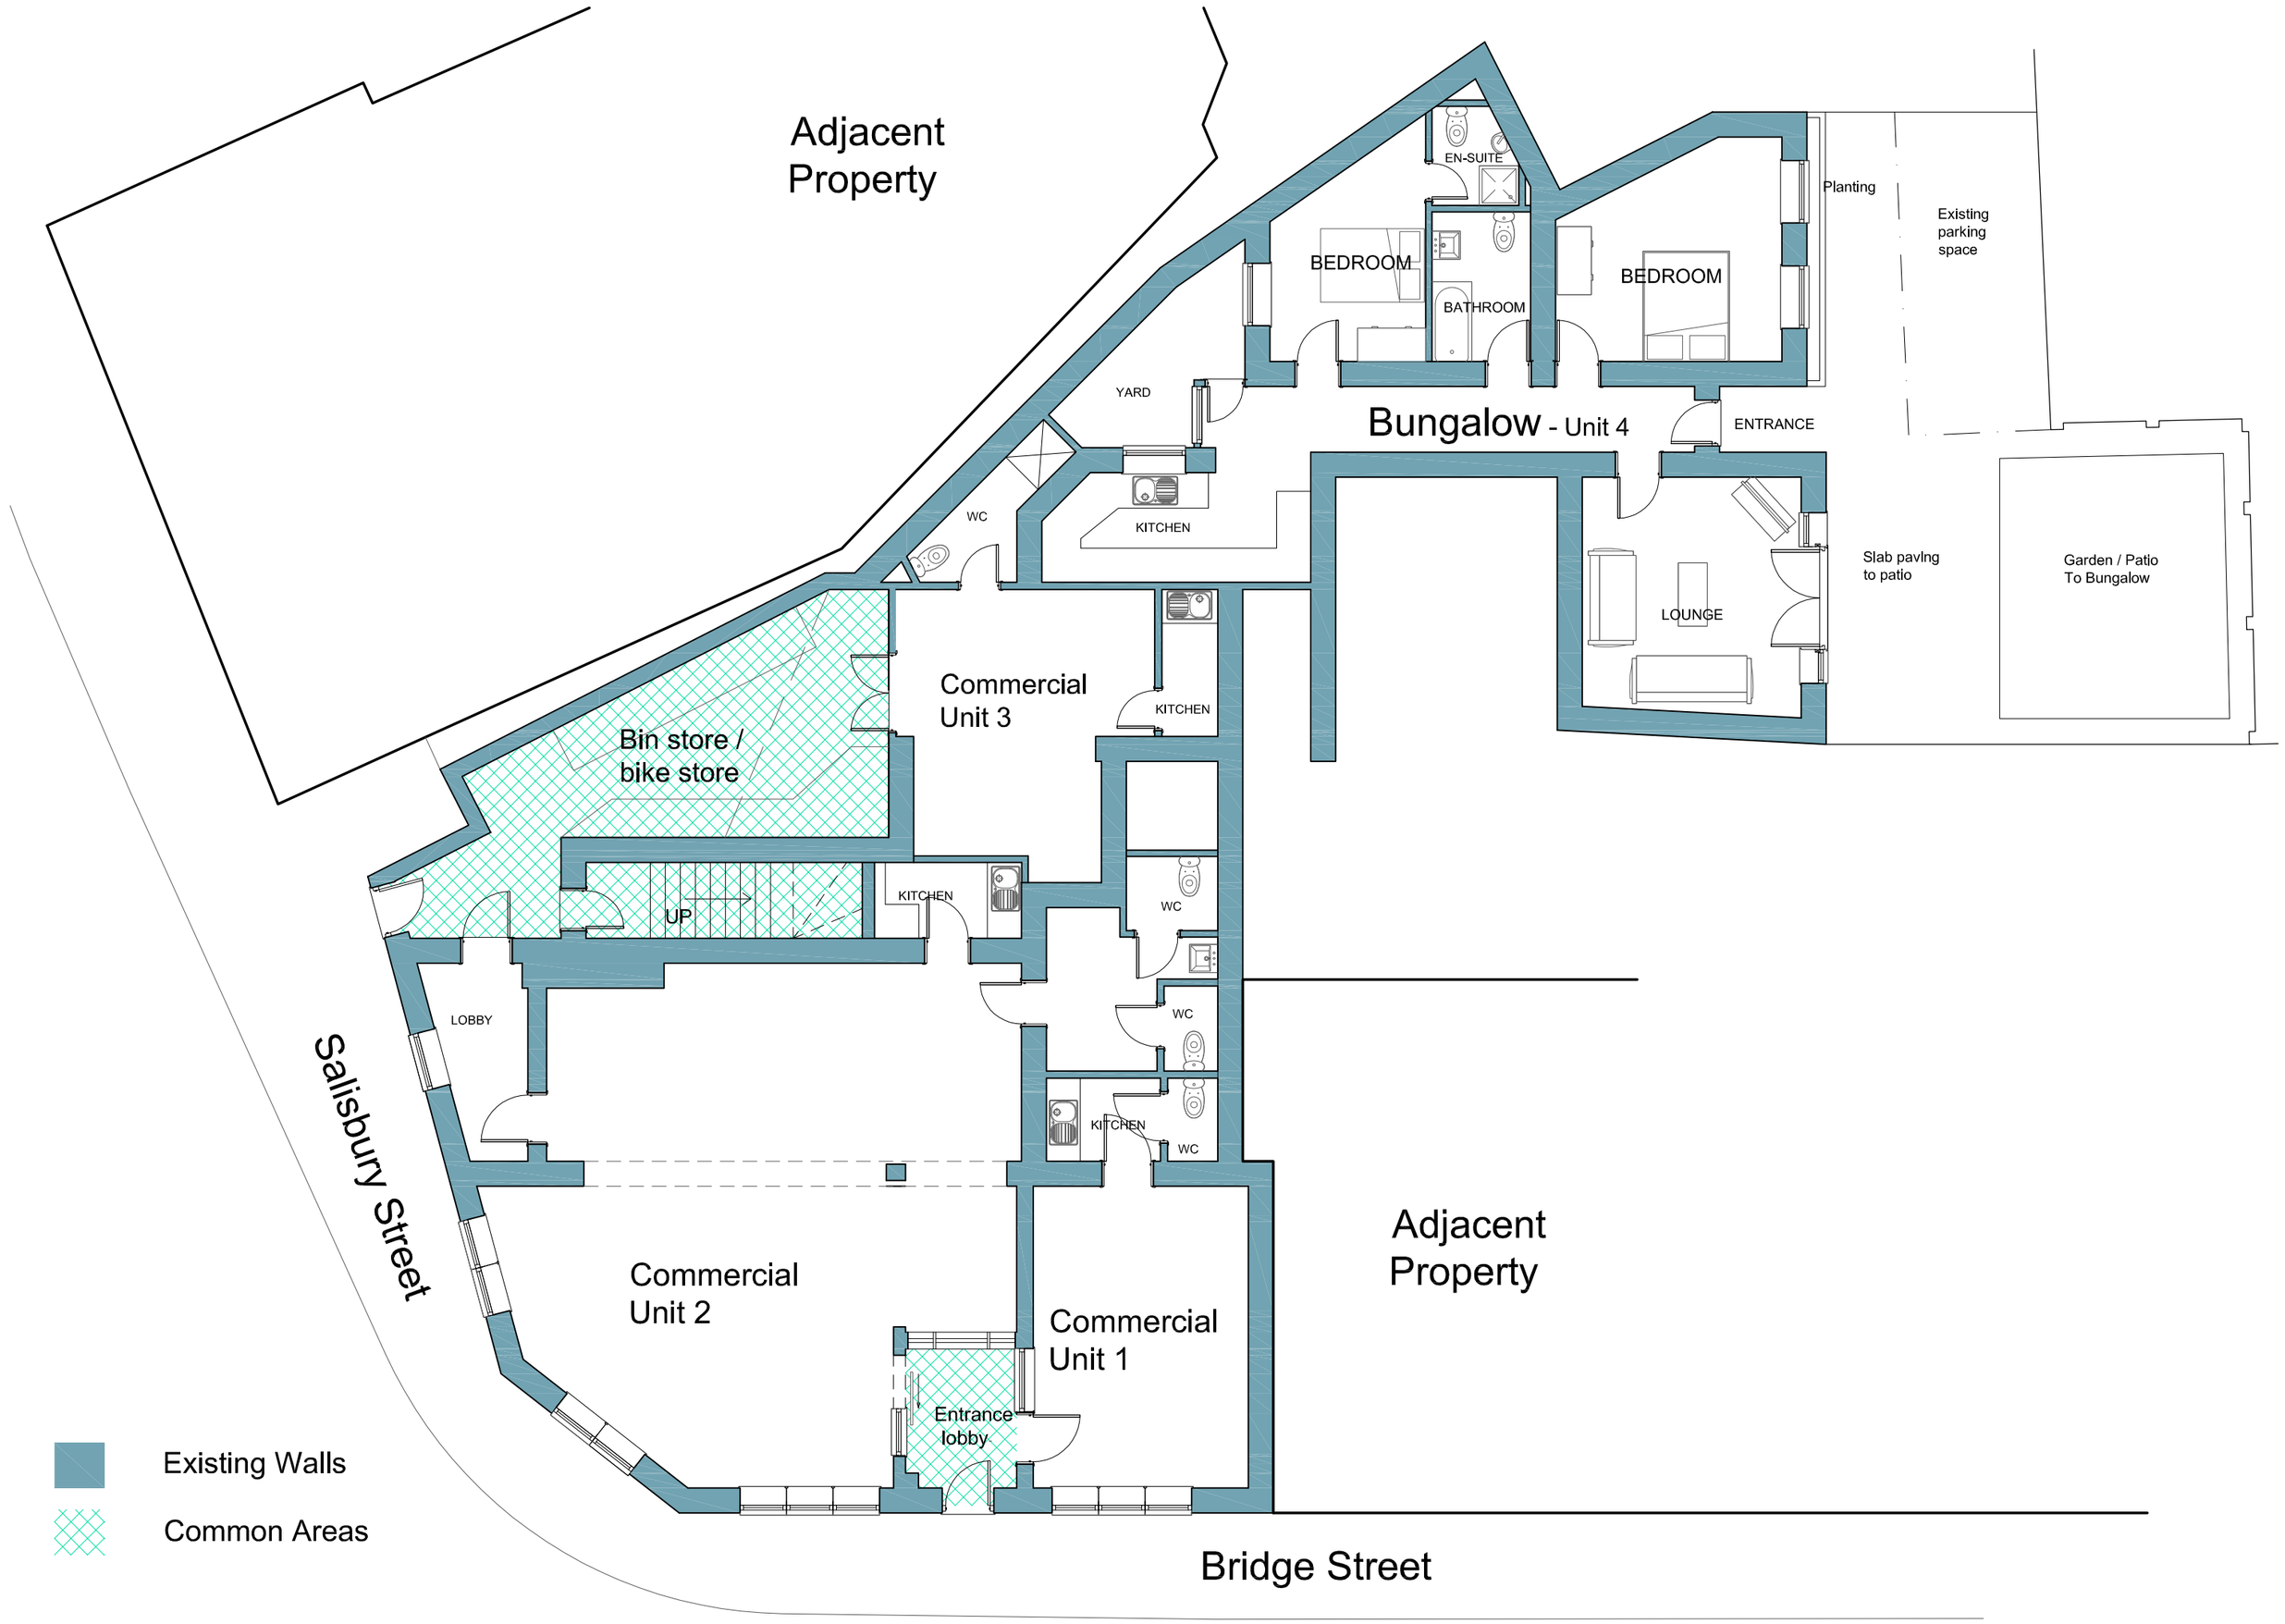

Ground Floor Commercial Units, Residential Bungalow
Bin and Bike Stores & Common Areas. 1:100 scale

M 1:100
0 0.5 1 2 3 4 5 6 7 8 9 10 [m]
1:100 scale @ A2

N

NOTE - THESE PLANS REPRESENT THE PROPERTY AS EXISTING.
REFER TO DRAWING 01 FOR LOCATION & BLOCK PLANS.

Do not scale off this drawing. All Dimensions to be checked on site by the contractor.

PLANNING

Architectural & Design Development
23 Firs Glen Road
Talbot Park
Bournmouth
Dorset
BH9 2LS
Tel:01202 - 527426
Mobile: 0781 1282136
Email : architecturaldesign_63@yahoo.co.uk

Client: Hants Developments Ltd,
18 Neals Corner,
2 Bath Road,
Hounslow,
Middlesex. TW3 3HJ

Project:
1 Bridge Street,
Fordingbridge,
Hampshire
SP6 1AH

Dwg Title:	Job No.
EXISTING GROUND FLOOR As Built	A/535
	Dwg No. 02
Scale: 1:100 @ A2	Date: Nov 2023
	Drawn: PN