M 1:100

0 0.5 1 2 3 4 5 6 7 8 9 10 [m]

1:100 scale

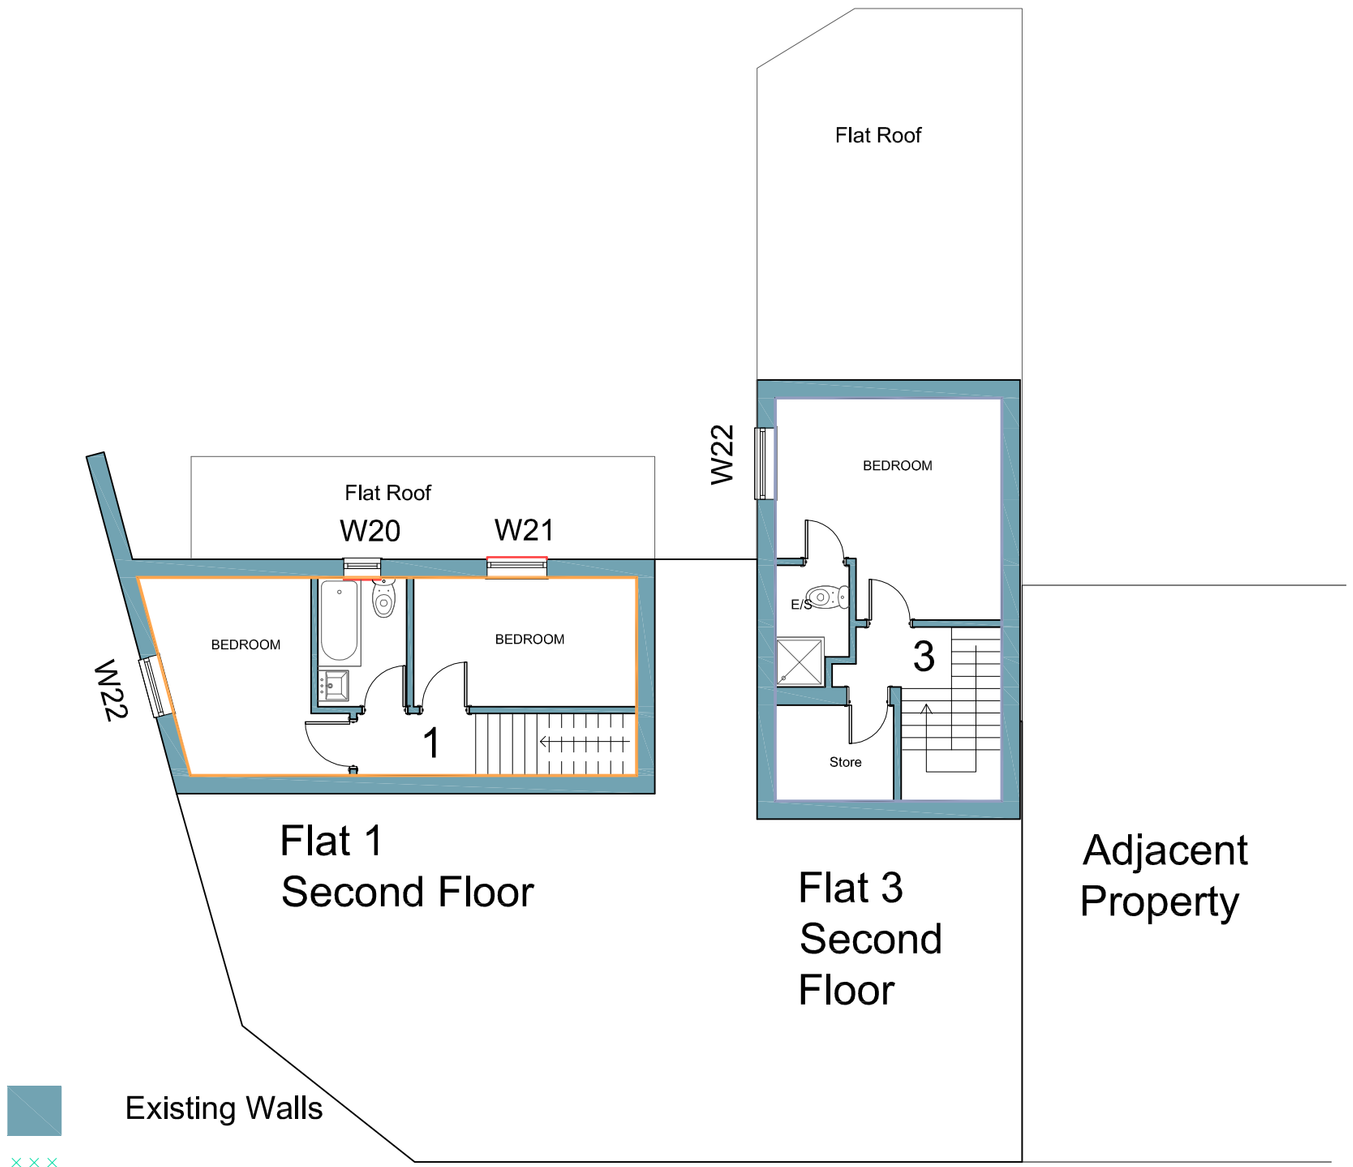

Existing Walls

Common Areas

Second Floor Plan 1:100 scale

FLOOR AREAS:

Flat 1 - First Floor	28.10 m²
Flat 1 -Second Floor	24.90 m²
	53.00 m²
Flat 2 - First Floor	66.80 m²
Flat 3- First Floor	46.50 m²
Flat 3 -Second Floor	24.30 m²
	70.80 m²

Do not scale off this drawing. All Dimensions to be checked on site by the contractor.

PLANNING

Architectural & Design Development

23 Firs Glen Road
Talbot Park
Bournmouth
Dorset
BH9 2LS

Tel:01202 - 527426
Mobile: 0781 1282136
Email : architecturaldesign_63@yahoo.co.uk

Client
Hants Developments Ltd,
18 Neals Corner,
2 Bath Road,
Hounslow,
Middlesex. TW3 3HJ

Project
1 Bridge Street,
Fordingbridge,
Hampshire
SP6 1AH

Dwg Title: Second Floor Plans Proposed – as built	Job No. A/535
	Dwg No. 04
Scale: 1:100 @ A2	Date: Nov 2023
	Drawn: PN