0 10 20 30 40 50 100 Millimetres @ A1

0 1 2 3 4 5 6 7.5 10mts

1:100 Scale

VERTICALITY CHECK OF WALL CENTRES & PIERS SECTIONS SOUTH-NORTH VIEW

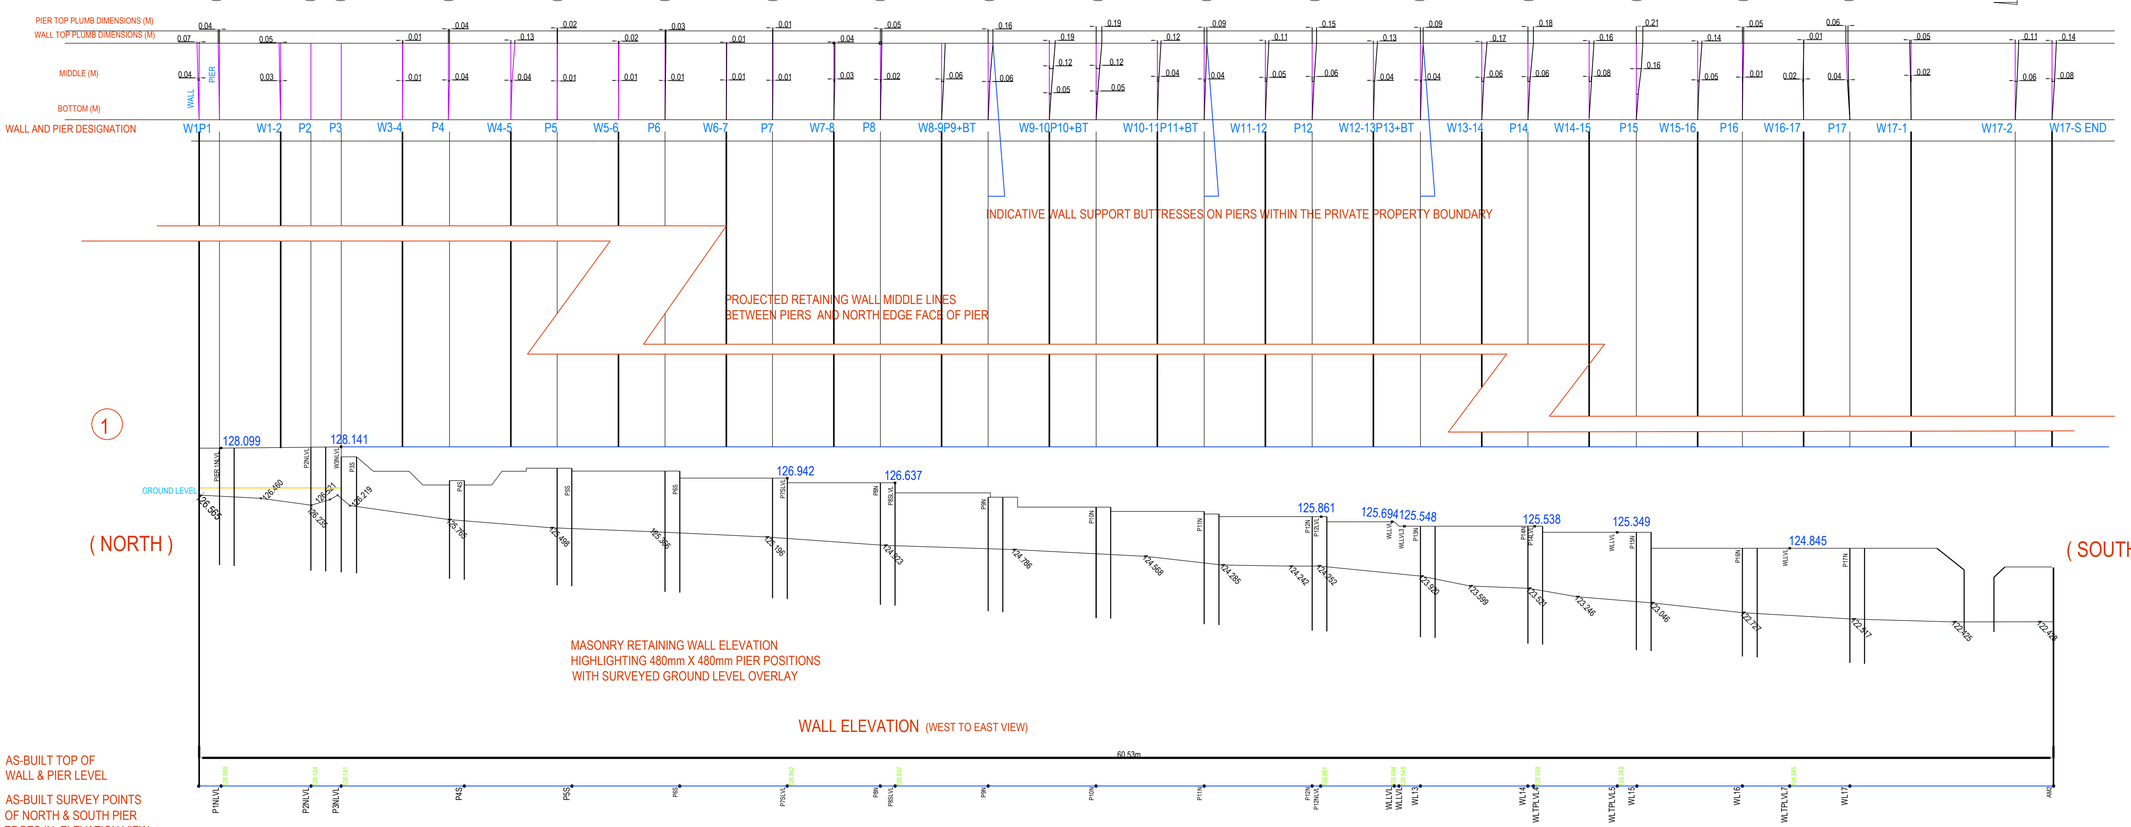

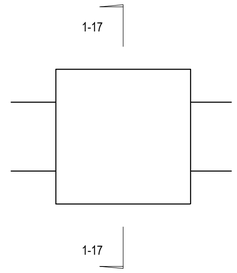

Notes

Do not scale, use figured dimensions only.

All dimensions to be verified on site prior to the commencement of any work or the production of any shop drawing. All discrepancies to be reported to the Architect.

This drawing is to be read in conjunction with all related Architect's and Engineer's drawings and any other relevant information.

This drawing is copyright © of TDC Architects Ltd.

Revision numbering; P= RIBA Stage 0-2, P= RIBA Stage 3,
T = RIBA Stage 4, C = RIBA Stage 5, R = RIBA Stage 6

REV	DATE	REVISION	INITIALS	CHECK
P1	15.11.2023	Planning issue	RMJB	SEL

DRAWING STATUS

- [ ] FOR DISCUSSION (RIBA STAGE 0-2)
- [x] FOR PLANNING (RIBA STAGE 3)
- [ ] FOR TENDER (RIBA STAGE 4)
- [ ] FOR CONSTRUCTION (RIBA STAGE 5)
- [ ] AS-BUILT (RIBA STAGE 6)
- [ ] AS-RECORDED (RIBA STAGE 6)

TDC ARCH DESIGN
The Design Collective Architects
2nd Fl. | 13 Museum St.
York | YO1 7DT
info@tdc-arch.design
www.tdc-arch.design

Client

Avery

Project

Proposed new boundary wall at
Barnet Grange Care Home

Drawing Title

Existing boundary wall survey

Scale	Date
1:100 @ A1	Nov 2023
Drawn by	Checked by
RMJB	SEL

Job No.	Drawing No.	Rev.
A232066	AL(0)001	P1