

Utility Assessment Report

For

Woolwich Road Limited

At

Park View Road Football Stadium & 1-3 Park View Road, Welling DA16 1SY

Mendick Waring Ltd.
Building Services Consulting Engineers
Lymehouse Studios
30/31 Lyme Street
London
NW1 0EE

Document Ref: 2927-UTY-0S-TMW-P2

November 2023

Introduction

Registered under London Borough of Bexley, Welling United FC shall be undergoing a regeneration of the stadium. The project proposals currently consist of the redevelopment of the stadium to provide a new stadium and associated facilities for Welling United FC, along with 104 residential units and commercial space. The positioning of the site shall remain in its existing location, surrounded by gardens of neighbouring residential houses, and a public park at the rear of the site and a cricket pitch to the east.

The area is bordered by Park View Road, and Roseacre Road respectively. Access to the development is via Park View Road.

New incoming services (water, electricity & Telecoms) shall be provided to the site and to be confirmed. Once the development is under construction, new incoming services will be provided as required.

Existing Incoming Site Services

Drainage Services (Thames Water)

As indicated on the Thames waters asset maps (*Appendix A*) and reflected on Mendick Waring's drawing no. 40-51-0S, currently the site is provided with separate foul and surface water drainage set out through existing manholes located within the site boundary.

There are currently 8No. surface drainage manholes which shall need to be inspected, and subject to diversion works if required.

Water Supply (Thames Water)

As indicated on the Thames waters asset maps (*Appendix B*) and reflected on Mendick Waring's drawing no. 40-53-0S, the surrounding area of site is operated by Thames Water. A 12" Trunk main & 4" Distribution main runs on the opposite side of the Park View Road and a 4" Distribution main runs along the footpath of Roseacre Road. There are two fire hydrants adjacent to the site located on Park View Road and Roseacre Road.

However, from the utility maps there appears to be no existing water infrastructure that crosses the site boundary. A survey is to be carried out to ascertain the existing water supplies with the site as these will require disconnection.

For the new scheme, a number of incoming mains water supplies shall serve the site for both domestic and fire suppression use. A communal break tank and booster pump set plant room shall be provided serving each core and providing pressurised water services to all apartments, with water meters provided on individual connections to apartments (meters located within the riser).

All new apartments will have flow restrictions to all sanitary fittings, to limit water consumption in line with current Building Regulations.

Where a fire tenders access is not possible the fire hydrant shall be retained/relocated to suit the developments aesthetics.

Gas Supply (SGN)

As indicated on the SGN asset maps (*Appendix C*) and reflected on Mendick Waring's drawing no. 40-54-0S, An 8" low pressure (LP) cast Iron Gas main runs along footpath the Park View Road and a 6" LP cast iron gas main runs along the footpath of Roseacre Road.

Within the site there is an existing a low-pressure (63 PE) gas mains that runs from the Park View Road through the site and terminates adjacent to the existing stand.

The gas main will need to be surveyed for its exact location and disconnected.

The proposed scheme and proposed energy strategy does not require a new gas supply for domestic heating and hot water services. Gas supplies to ground floor commercial units may be required subject to further design and employer requirements.

Electricity Supply (UKPN)

As indicated on the UKPN asset maps (*Appendix D*) and reflected on Mendick Waring's drawing no. 40-60-0S there are several low voltage cables and high voltage cables running along the Park View Road and adjacent Roseacre Road.

As indicated on UKPN's asset maps, there is an existing sub-station located within the site itself with 4 No. Low voltage cables & 2 No High voltage cables running from the sub-station and through the site boundary.

The electrical mains cables shall need to be inspected and a disconnection or diversions of services shall be required and confirmed.

Further discussion with UPKN will need to be carried out in regards to the relocation/disconnection works associated with the existing sub-station.

In addition to this, there are 3 No. Low Voltage cables that run from the Park View Road and terminate within the site boundary as indicated on UKPN's asset maps. These electrical mains shall need to be inspected and a disconnection of service to be confirmed.

Furthermore, 4No.electrical services for street furniture run close to the vicinity of the site boundary and shall be required to be inspected and possibly a re-location of service to be confirmed.

The new scheme will require a new onsite substation proposed to be located on the west of the site accessible from Roseacre Road.

BT Openreach

As indicated on the BT Openreach asset maps (*Appendix E*) and reflected on Mendick Waring's drawing no. 40-65-0S, there BT infrastructure that runs along the Park View Road and adjacent Roseacre Road. With 3 No BT Boxes and 1 No. BT chamber that runs along the front of the site.

There is currently a BT cable that runs from the Park View Road and terminates within the site boundary. This BT cable shall need to be inspected and a disconnection of service to be confirmed.

Virgin Media

There is sufficient capacity within the local VM network to supply the proposed development.

As indicated on the Virgin Media asset maps (Appendix F) and reflected on Mendick Waring's drawing no. 40-64-0S, the surrounding area of site is operated by Virgin Media with 2 No.VM chamber/poles that located at the front of the site.

However, there appears to be no existing Virgin Media infrastructure that crosses the site boundary.


CONCLUSION

In summary, Utility Services are available to serve the development including Electricity, Gas, Water and Fibre.

Detailed applications for these services will be developed and available within the next project stage to ascertain further detail on capacities, opportunities, and the extent of works needed. It is not envisaged that the existing residents will be unduly compromised by the development.



Appendix A – Thames Water Sewer Asset map search

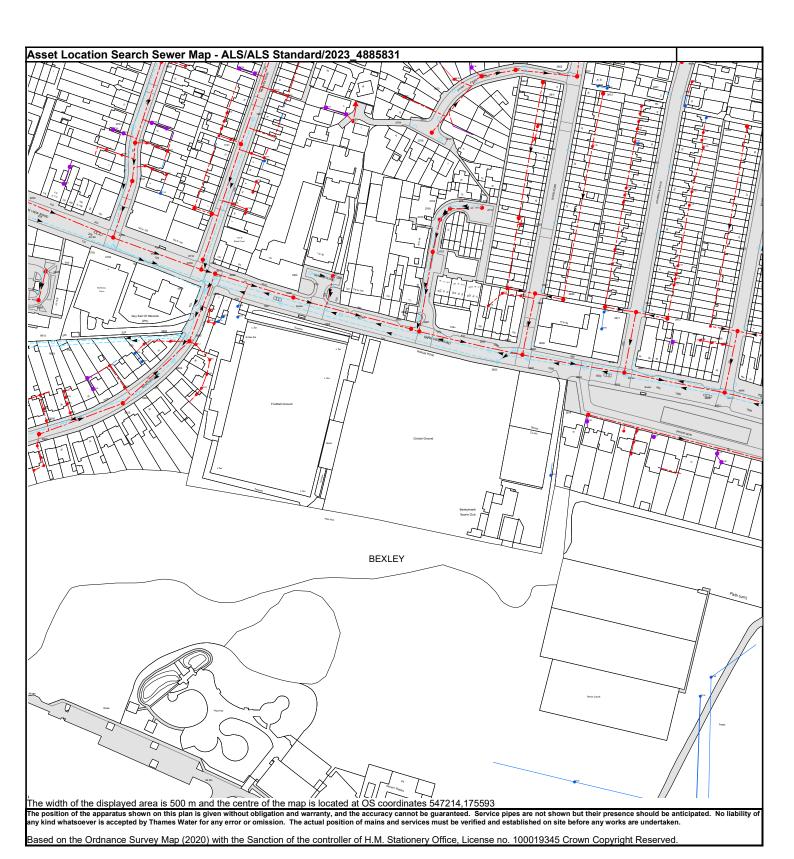

Thames Water Utilities Ltd, Property Searches, PO Box 3189, Slough SL1 4W, T 0800 009 4540 E searches@thameswater.co.uk I www.thameswater-propertysearches.co.uk


Manhole Reference	Manhole Cover Level	Manhole Invert Level
371A	n/a	n/a
381F	n/a	n/a
381G 3813	n/a n/a	n/a n/a
3801	45.29	44.33
4809	45.39	43.7
4803	45.31	44.44
4811	n/a	n/a
481J	n/a	n/a
471C	n/a	n/a
471B	n/a	n/a
4810	n/a	n/a
4703 281B	n/a n/a	n/a n/a
2801	44.5	43.41
2701	43.96	42.88
2806	44.59	42.44
2710	43.99	42.44
2805	44.83	42.2
271B 271A	n/a	n/a
3803	n/a 44.84	n/a 43.94
3804	44.81	43.79
371J	n/a	n/a
3711	n/a	n/a
371H	n/a	n/a
3811	n/a	n/a
3703	44.1	n/a
3704	44.67 45.01	43.63
3802 3810	45.01 45	43.89 41.92
371D	n/a	n/a
381D	n/a	n/a
3812	n/a	n/a
381C	n/a	n/a
371F	n/a	n/a
371E	n/a	n/a
371L 371K	n/a n/a	n/a n/a
371G	n/a	n/a
1602	42.48	41.73
171F	n/a	n/a
171D	n/a	n/a
171A	n/a	n/a
171B	n/a	n/a
171G 171H	n/a n/a	n/a n/a
1711	n/a	n/a
1701	43.11	41.15
1801	43.29	41.97
181H	n/a	n/a
181F	n/a	n/a
181G 181C	n/a n/a	n/a n/a
1603	42.77	41.37
1607	42.73	41.33
2707	43.31	41.3
2708	43.75	41.7
2705	43.73	42.21
2709	43.8	41.92
2702 2703	43.79 44.04	42.48 42.87
2703	44.04 44.12	42.87
2704	44.02	43.1
181J	n/a	n/a
2803	44.19	43.36
1811	n/a	n/a
281A	n/a	n/a
2802 281G	44.51 n/a	43.59 n/a
281G 461C	n/a n/a	n/a n/a
461B	n/a	n/a
461A	n/a	n/a
471A	n/a	n/a
4702	44.73	43.76
3701	44.37	42.95
471F 471E	n/a n/a	n/a
3702	n/a 44.85	n/a 43.95
471D	n/a	n/a
371C	n/a	n/a
371B	n/a	n/a
9606	42.75	41.25
9620	42.79	n/a
0702	43.01	39.56
0703	43	41.86
0708 971A	43.08 n/a	40.45 n/a
	n/a n/a	n/a n/a
19/1B		
971B 061M	n/a	n/a

Manhole Reference	Manhole Cover Level	Manhole Invert Level
061S	n/a	n/a
0601 0602	42.32 42.37	41.05 39.25
0610	42.36	40.44
0709	42.44	40.41
0704	42.44	41.26
0710	42.48	40.74
0711	n/a	n/a
0712 171E	n/a n/a	n/a n/a
071H	n/a n/a	n/a n/a
0707	43.78	41.17
0711	n/a	n/a
071J	n/a	n/a
261A	n/a	n/a
261B	n/a	n/a
2609 2604	n/a 42.92	n/a 41.77
261C	n/a	n/a
2608	43.13	39.81
3601	43.17	39.7
3606	43.14	42.13
3608	43.65	40.62
3607 3609	43.58	42.44
3609 361B	n/a n/a	n/a n/a
361A	n/a n/a	n/a n/a
3613	n/a	n/a
3604	43.55	42.19
3611	43.78	40.44
3605	43.84	42.55
3612	n/a	n/a
461J 461E	n/a n/a	n/a n/a
4607	n/a	n/a
461F	n/a	n/a
461G	n/a	n/a
4609	44.18	40.47
4603	44.28	42.83
071В 071Н	n/a n/a	n/a n/a
071A	n/a n/a	n/a n/a
071I	n/a	n/a
0701	44.4	40.2
0706	44.32	41.74
071K	n/a	n/a
071F	n/a	n/a
071M	n/a	n/a
071N 0803	n/a 44.72	n/a 42.1
071L	n/a	n/a
071G	n/a	n/a
081B	n/a	n/a
081A	n/a	n/a
n/a	n/a	n/a
0710	n/a	n/a
081H 081G	n/a n/a	n/a n/a
171C	n/a	n/a
181B	n/a	n/a
351A	n/a	n/a
351B	n/a	n/a
3614	43.19	42.17
4601 4608	43.78 43.78	40.14 39.52
4604	43.79	42.55
3603	43.48	39.87
3610	43.48	39.67
3602	43.29	39.81
331A	n/a	n/a
441A	n/a	n/a
441B 351G	n/a n/a	n/a n/a
451B	n/a n/a	n/a n/a
351E	n/a	n/a
451A	n/a	n/a
351D	n/a	n/a
351F	n/a	n/a
351C	n/a	n/a
061O 061N	n/a n/a	n/a n/a
	n/a 42.27	n/a 38.55
	n/a	n/a
0606		
	42.19	38.6

Manhole Reference	Manhole Cover Level	Manhole Invert Level
161A	n/a	n/a
161B	n/a	n/a
1601	42.26	41.3
1606	42.27	40.33
1604	42.49	39.29
2606	42.69	40
2607	42.7	39.98
2601	43.12	40.88
2602	43.01	39.49
2603	42.85	41.75
9509	n/a	n/a
9619	42.27	40.52
9507	n/a	n/a
9605	42.29	41.01
9502	43.76	41.84
961F	n/a	n/a
9508	n/a	n/a
961E	n/a	n/a
9506	n/a	n/a
951B	n/a	n/a
9612	41.93	n/a
9613	n/a	n/a
9505	43.41	38.35
061B	n/a	n/a
061A	n/a	n/a
061D	n/a	n/a
0612	42.81	41.18
061E	n/a	n/a
061Q	n/a	n/a
0607	42.59	38.43
061P	n/a	n/a
I		

The position of the apparatus shown on this plan is given without obligation and warranty, and the accuracy cannot be guaranteed. Service pipes are not shown but their presence should be anticipated. No liability of any kind whatsoever is accepted by Thames Water for any error or omission. The actual position of mains and services must be verified and established on site before any works are undertaken.



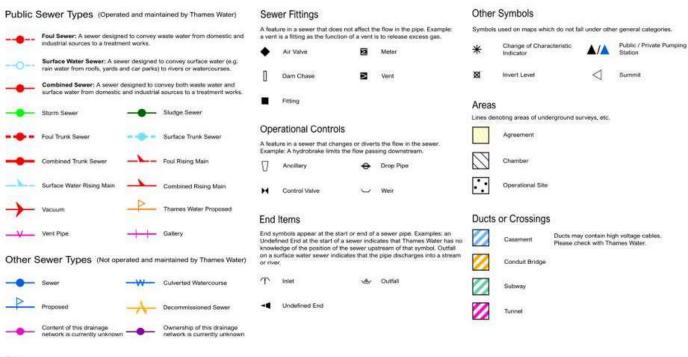

- Notes:

 1) All levels associated with the plans are to Ordriance Datum Newlyn.

 2) All measurements on the plan are metric.

 3) Arrows (on gravity fed sewers) or flecks (on rising mains) indicate the direction of flow.

 4) Most private pipes are not shown on our plans, as in the past, this information has not been recorded.
- 5) 'ne' or '0' on a manhole indicates that data is unavailable.
 6) The text appearing alongside a sewer line indicates the internal diameter of the pipe in millimeters.
 Text next to a manhole indicates the manhole reference number and should not be taken as a measurement.
 If you are unsure about any text or symbology, please contact Property Searches on 0800 009 4540.

Appendix B – Thames Water Clean Water Asset map search




on the Ordnance Survey Map (2020) with the Sanction of the controller of H.M. Stationery Office, License no. 100019345 Crown Copyright Reserved.




Asset Location Search - Water Key

Water Pipes (Operated & Maintained by Thames Water) Valves **Operational Sites** Distribution Main: The most common pipe shown on water maps. With few exceptions; domestic connections are only made to distribution mains. General PurposeValve Booster Station Air Valve -0 Other ▲ Pressure ControlValve Other (Proposed) Trunk Main: A main carrying water from a source of supply to a treatment plant or reservoir, or from one treatment plant or reservoir to another. Also a main transferring water in bulk to smaller water mains used for supplying individual customers. X Customer Valve Pumping Station ▲ Service Reservoir Shaft Inspection Supply Main: A supply main indicates that the water main is used as a supply for a single property or group of properties. Hydrants Treatment Works Single Hydrant - Unknown Fire Main: Where a pipe is used as a fire supply, the word FIRE will Water Tower be displayed along the pipe. Meters Metered Pipe: A metered main indicates that the pipe in question supplies water for a single property or group of properties and that quantity of water passing through the pipe is metered even though there may be no meter symbol shown. Meter Meter Other Symbols Data Logger Transmission Tunnel: A very large diameter water pipe. Most tunnels are buried very deep underground. These pipes are not expected to affect the structural integrity of buildings shown on the **End Items** Casement: Ducts may contain high voltage cables, Please check with Thames Water. Symbol indicating what happens at the end of $\dot{\circ}$ a water main. map provided. Blank Flange Proposed Main: A main that is still in the planning stages or in the process of being faild. More details of the proposed main and its reference number are generally included near the main. Capped End Emptying Pit Other Water Pipes (Not Operated or Maintained by Thames Water) Other Water Company Main: Occasionally other water company water pipes may overlap the border of our clean water coverage ares. These mains are denoted in purple and in most cases have the owner of the pipe displayed along them. Undefined End PIPE DIAMETER DEPTH BELOW GROUND Manifold Lip to 300mm (12") 900mm (3) 300mm - 600mm (12" - 24") Customer Supply 1100mm (3'8") Private Main: Indiates that the water main in question is not owned by Thames Water. These mains normally have text associated with them indicating the diameter and owner of the pipe. Fire Supply 600mm and bigger (24° plus) 1200num (4')

Appendix C – Southern Gas Network (SGN) Asset map search

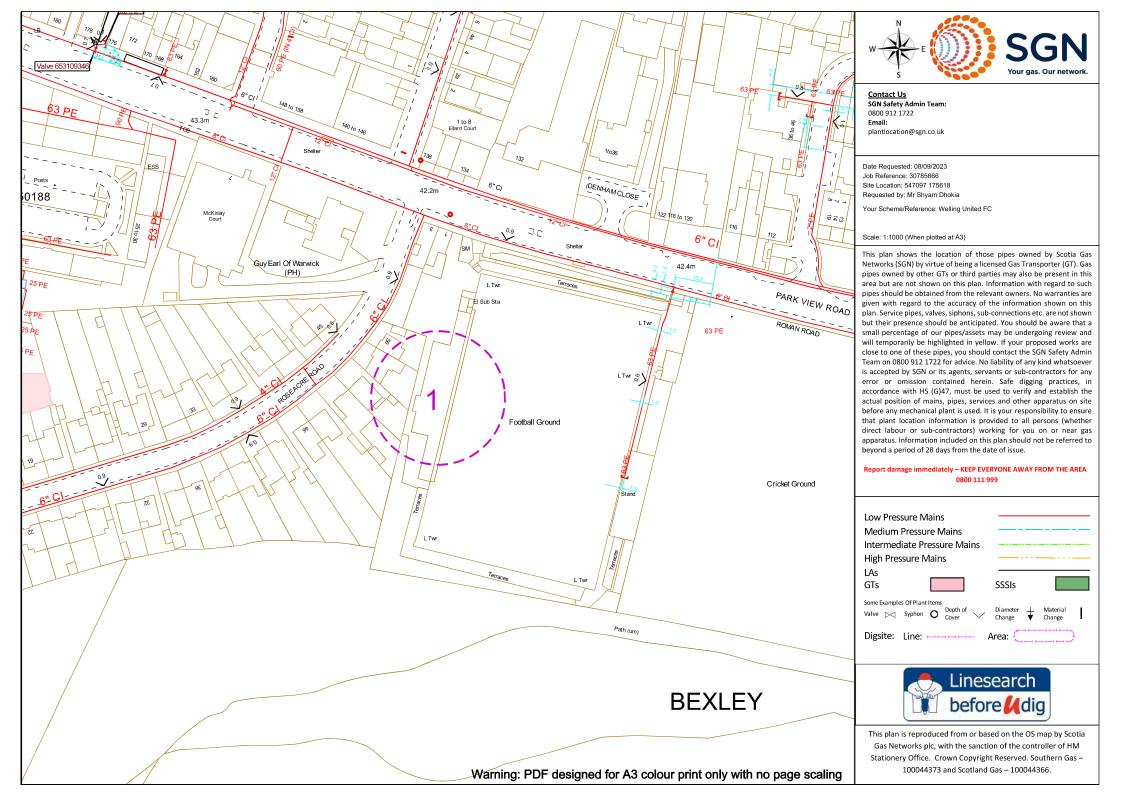

Appendix D – UK Power Networks (UKPN) Asset map search

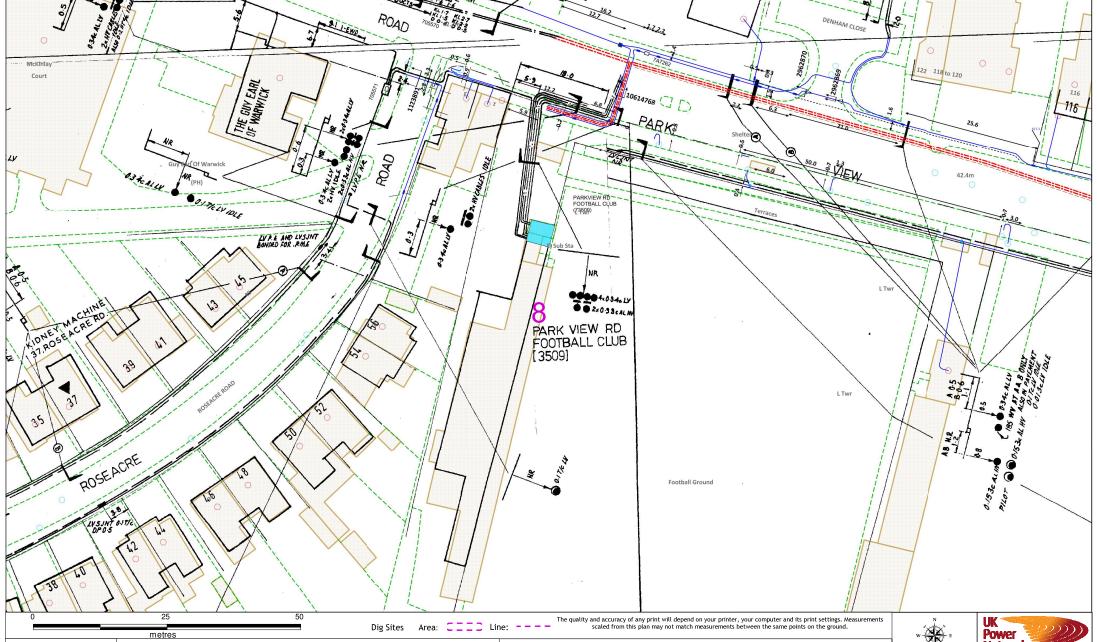

This plan must be used with the attached 'Symbols' document

Date Requested: 03/10/2023

Site Location: 546872 175405

Job Reference: 30916858

Requested by:

United FC

Mr Shyam Dhokia

1. The position of the apparatus shown on this drawing is believed to be correct but the original landmarks may have been altered since the apparatus was installed.

- 2. The exact position of the apparatus should be verified use approved cable avoidance tools prior to excavation using suitable hand 3. It is essential that trial holes are carefully made avoiding the use of mechanical tools or picks until the exact location of all the
- cables have been determined.

- 4.1 It must be assumed that there is a service cable into each property, lamp column and street sign, etc.

 5. All cables must be treated as being live unless proved otherwise by UK Power Networks.

 6. The information proved must be given to all people working near UK Power Networks plant and equipment. Do not use plans more than 3 months after the issue date for excavation purposes.

 7. Please be aware that electric cables/lines belonging to other owners of licensed electricity distribution systems may be present and
- it is your responsibility to identify their location.

Your Scheme/Reference: Welling Scale: 1:500 (When plotted at A3)

- 1. UK Power Networks does not warrant that the information provided to you is correct. You rely upon it at your own risk.

 2. UK Power Networks does not exclude or limit its liability if it causes the death of any persons or causes personal injury to a person.
- 3. Subject to paragraph 2 UK Power Networks has no liability to you in contract, in tort (including negligence), for breach of statutory duty or otherwise for any loss, damage, cost, claims, demands, or expenses that you or any third party may suffer or incur as a result of using
- the information provided whether for physical damage to property or for any economic loss (including without limitation loss of profit, loss of opportunity, loss of savings, loss of goodwill, loss of business, loss of use) or any special or consequential loss or damage whatsoever. 4. This plan has been provided to you on the basis of the terms of use set out in the covering letter that accompanies this plan. If you do not accept and/or do not understand the terms of use set out in the covering letter you must not use the plan and must return it to the
- sender of the letter. 5. You are responsible for the security of the information provided to you. It must not be given, sold or made available upon payment of a fee to a third party.





PHONE 0800 056 5866 EMERGENCY - If you damage a cable or line Phone 0800 783 8838




ALWAYS LOOK UP BEFORE YOU START WORK Refer to HSE Guidance note GS6

Maps produced at 1:2500 scale are Geo-Schematics which show LV mains cables and overhead lines (in some cases all voltages). Prior to carrying out excavations you must refer to the 1:500 records to determine the location of all known underground plant and equipment.

Reproduced by permission of Ordnance Survey on behalf of HMSO. © Crown copyright and database rights 2023. All rights reserved. Ordnance Survey Licence numbers 100019450. Data has been added to the Ordnance Survey base map; all proprietary rights in such additional data are and shall remain the exclusive property of © London Power Networks pic or Eastern Power Networks pic or South Eastern Power Networks pic each being a distribution licensee under section 6(1)(c) of the Electricity Act 1989 for the relevant distribution services area as that term is defined in such licensee's distribution licensee. All rights in such data reserved. Plans generated by DigSAFE Pro™ software provided by LinesearchbeforeUdig.

Appendix E – BT Openreach Asset map search

Maps by email Plant Information Reply

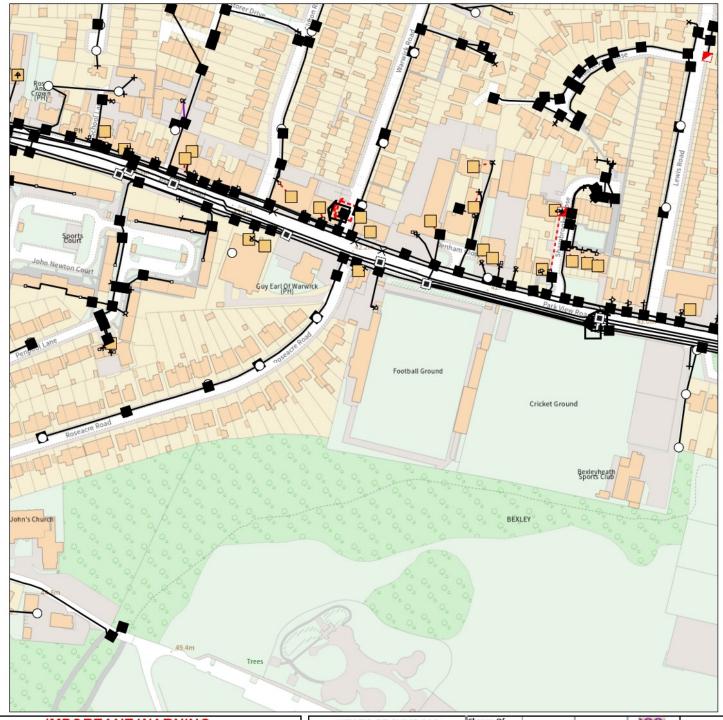

IMPORTANT WARNING
Information regarding the location of BT apparatus is given for your assistance and is intended for general guidance only. No guarantee is given of its accuracy. It should not be relied upon in the event of excavations or other works being made near to BT apparatus which may exist at various depths and may deviate from the marked route



CLICK BEFORE YOU DIG
FOR PROFESSIONAL FREE ON SITE ASSISTANCE PRIOR TO COMMENCEMENT OF EXCAVATION WORKS INCLUDING LOCATE AND MARKING SERVICE

email <u>cbyd@openreach.co.uk</u>

ADVANCE NOTICE REQUIRED (Office hours: Monday - Friday 08.00 to 17.00) www.openreach.co.uk/cbyd

Accidents happen

If you do damage any Openreach equipment please let us know by calling 0800 023 2023 (opt 1 + opt 1) and we can get it fixed ASAP

Reproduced from the Ordnance Survey map by BT by permission of Ordnance Survey on behalf of the Controller of Her Majesty's Stationary Office (C) Crown Copyright British Telecommunications plc 100028040

KEY TO BT SYMBOLS		Change Of State	+	Hatchings	XX	
	Planned	Live	Split Coupling	×	Built	
PCP	:	Ø	Duct Tee		Planned	
Pole	0	0	Building		Inferred	^
Вох			Kiosk	(K)	Duct	
Manhole					shown using da	
Cabinet	Û	Û	BT Symbols not listed above may be disregarded. Existing BT Plant may not be recorded. Information valid at time of preparation. Maps are			
					ter the date of p	
	Pending Add	In Place	Pending Remove	Not In Use		
Power Cable	H-H	NN	AA;	HH]	
			1		-	


BT Ref: SHL04023G

Map Reference: (centre) TQ4709775619 Easting/Northing: (centre) 547097,175619

Issued: 08/09/2023 16:02:52


Power Duct / //

Appendix F – Virgin Media Asset map search

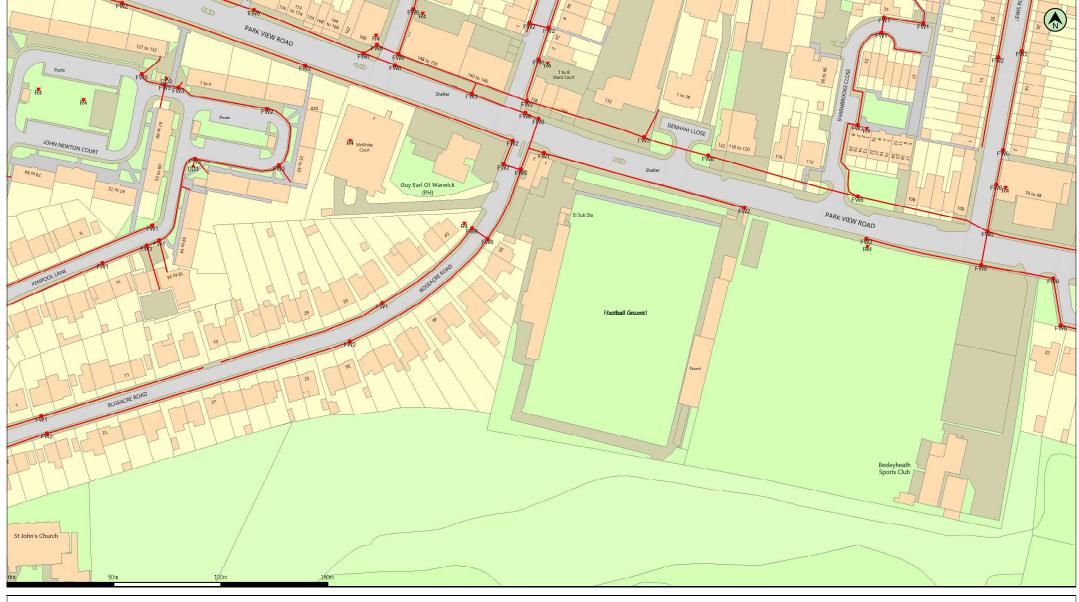

(c) Crown copyright and database rights 2023 Ordnance Survey 100019209 Date: 11/09/23 Scale: 1:1250 Map Centre: 547097,175619 Data updated: 31/07/23 Our Ref: 1268392 - 1 Telecoms Plan A3

Important Information - please read The purpose of this plan is to identify Virgin Media apparatus. We have tried to make it as accurate as possible but we cannot warrant its accuracy. In addition, we caution that within Virgin Media apparatus there may be instances where mains voltage power cables have been placed inside green, rather than black ducting, Further details can be found using the "Affected Posteos pdf", which can be downloaded from this website. Therefore, you must not rely solely on this plan if you are carrying out any excavation or other works in the vicinity of Virgin Media apparatus. The actual position of any underground service must be verified by cable detection equipment, etc. and established on site before any mechanical plant is used. Accordingly, unless it is due to the negligence of Virgin Media, its employees or agents, Virgin Media will not have any liability for any omissions or inaccuracies in the plan or for any loss or damage caused or arising from the use of and/or any reliance on this plan. This plan is produced by Virgin Media Limited (c) Crown copyright and database rights 203 Ordnance Survey 100019209.

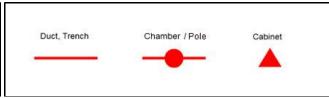

shyam@mwl-group.com

Welling United FC

Welling United FC, DA16 1SY

