


Do not scale dimensions off drawings. Use written or calculated dimensions. The contractor is responsible for checking all dimensions before ordering or starting work.

This drawing has been produced for the client for the project on the site shown. It was prepared for a purpose agreed with the client and will have a commensurate degree of accuracy. It is not a record "as built". This drawing is not intended for use by any other person or for any other purpose than that specified here. Inkpen Downie Architecture & Design accept no liability whatsoever if this drawing is used by any other person or for any other purpose.

NOTES

- Area of New Building
- Area of Existing Building

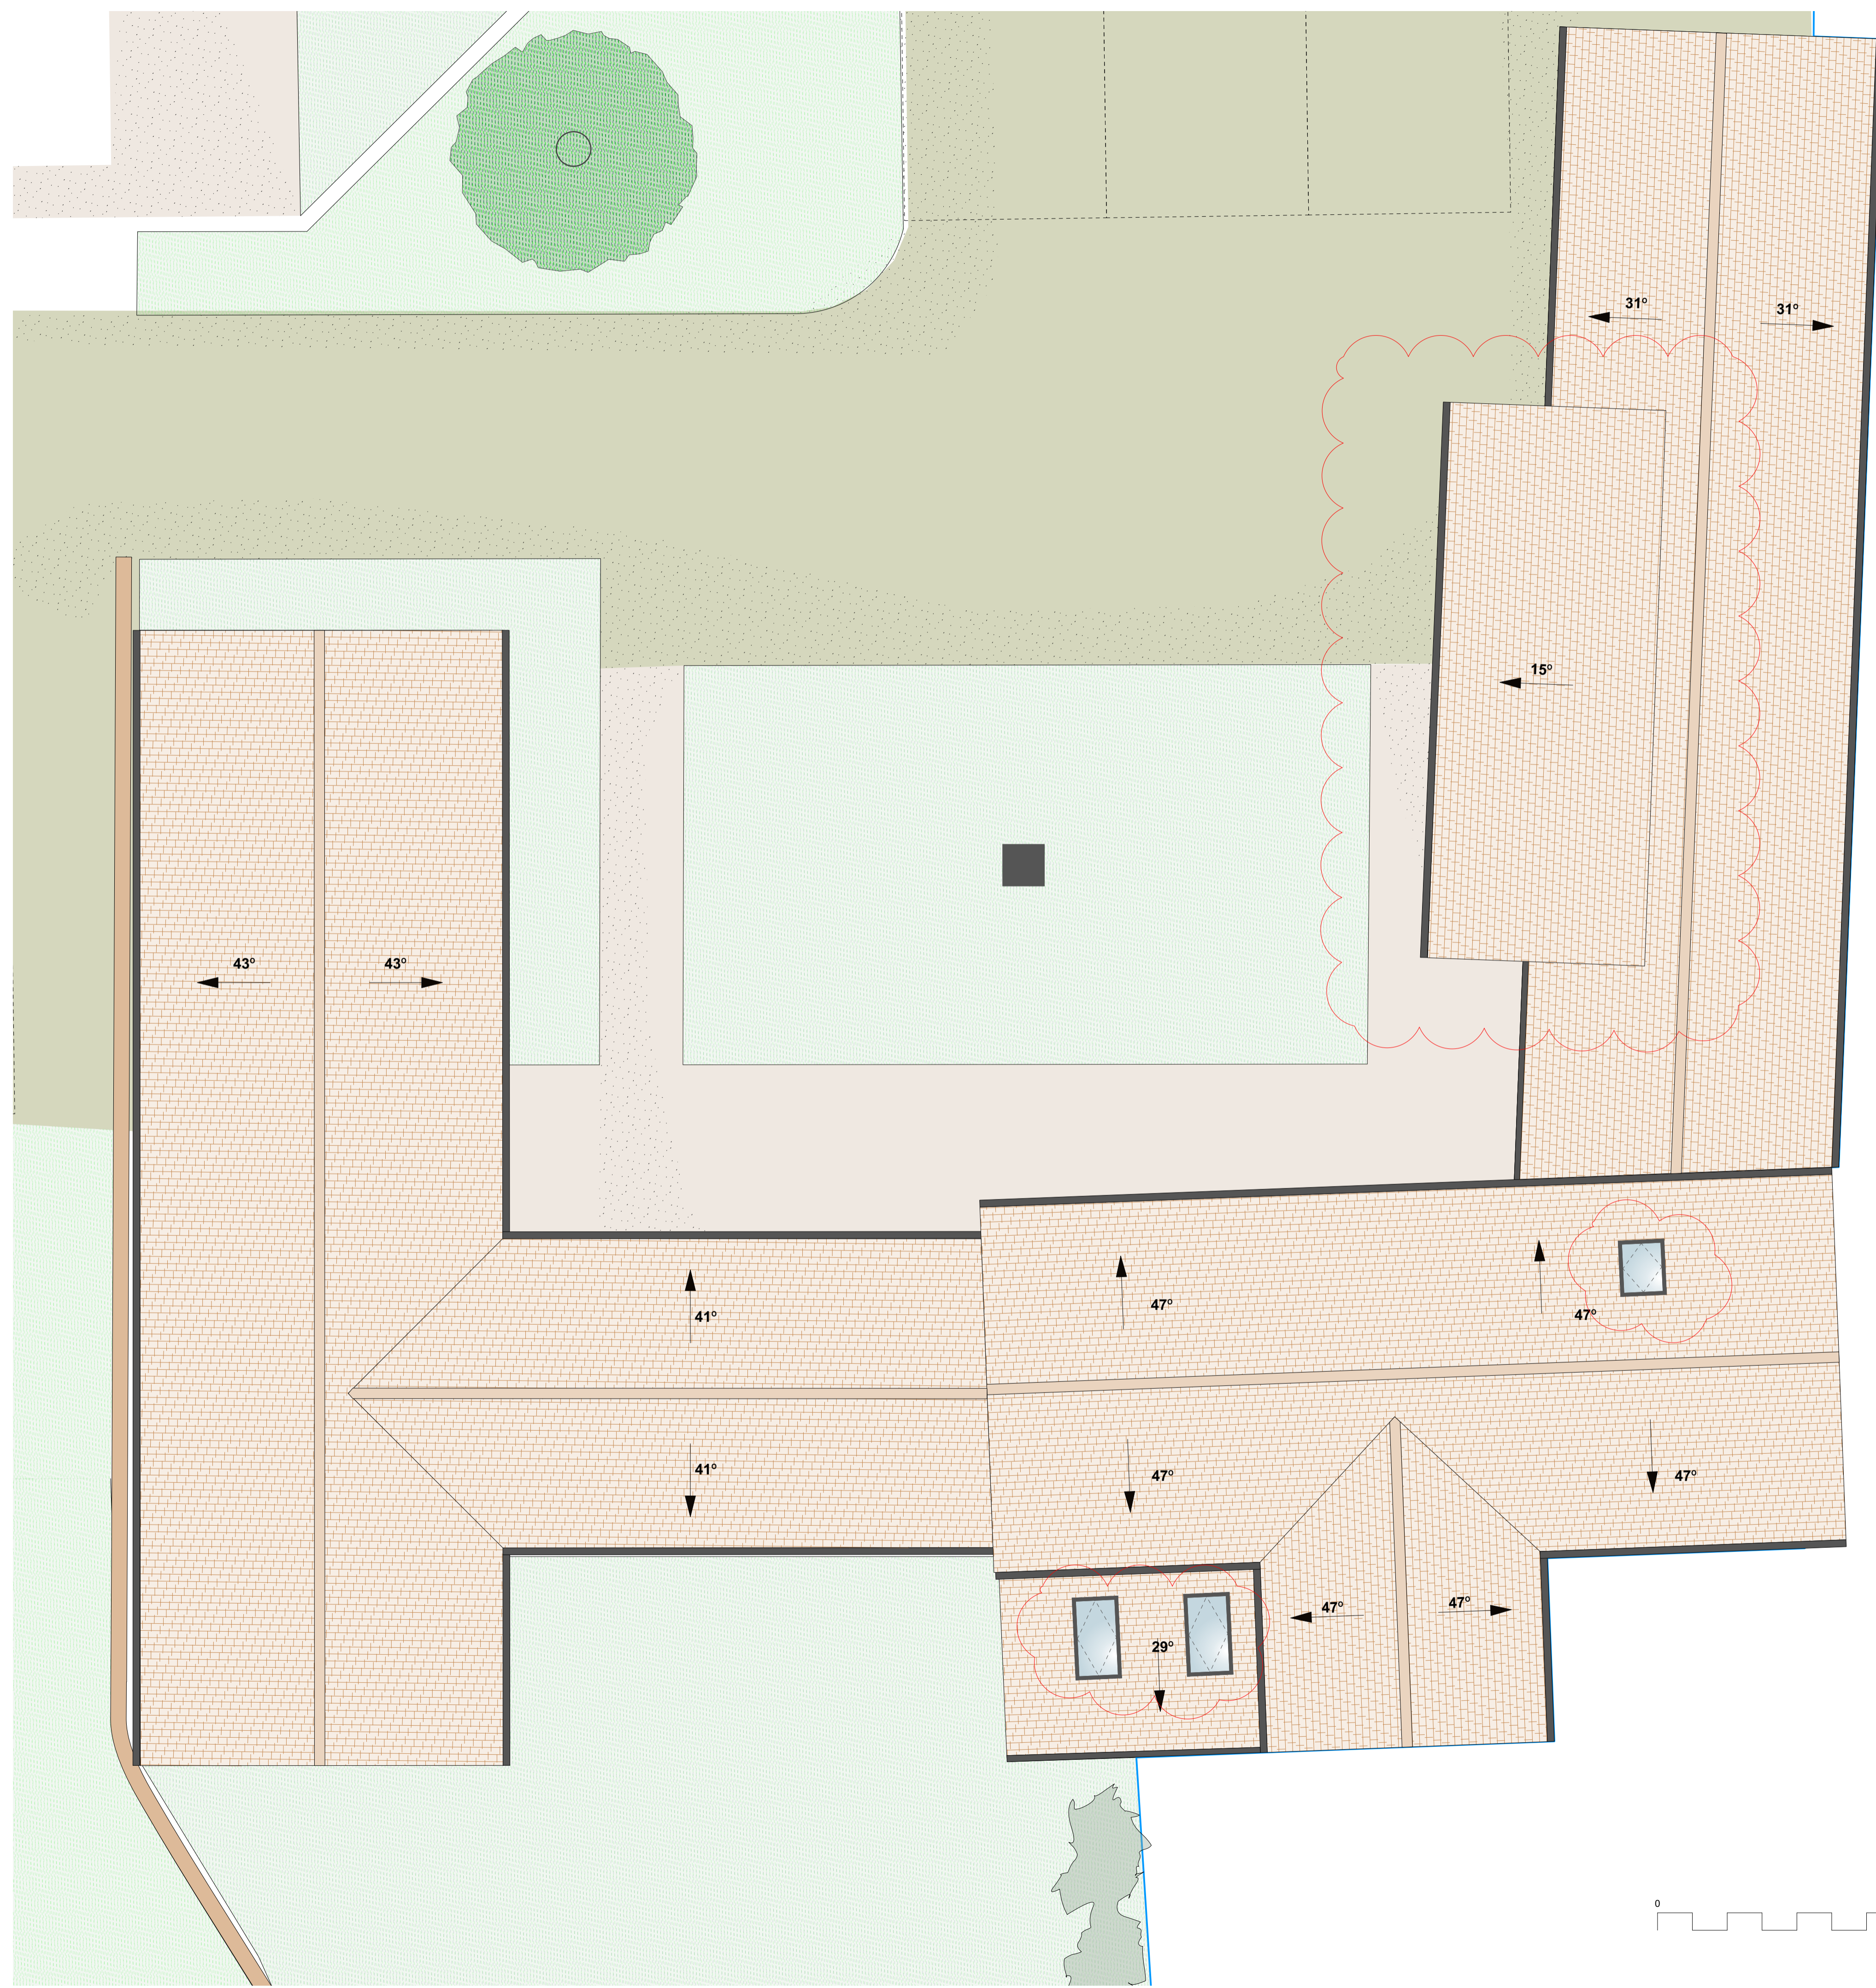

P03	18/08/2023	Timber Barn Change	BB
P02	10/08/2023	Extension to Dairy Barn Wing	BB
Rev	Date	Revision	Drawn By

id
 Inkpen Downie Architecture & Design Ltd
 2 Balkerne House • Balkerne Passage • Colchester • CO1 1PA
 Tel 01206 577 244 • Fax 01206 563 377
 arch@inkpendownie.co.uk • www.inkpendownie.co.uk

Drawing Status
FOR INFORMATION
 Project

Conversion to Residential
 Canterbury Tye Barns
 Client
 Mr & Mrs Yardy

Cad File	Scale	Drawn By / Date	Checked By / Date
	1:50@A1	BB Aug 23	JC Aug 23

Title
 Barn C (Proposed)
 Proposed Roof Plan
 Drawing No.
 1816-IDA-XX-XX-DR-A-123
 Rev No.
 P02

Copyright reserved by Inkpen Downie Architecture & Design. This drawing shall not be reproduced or used without prior permission of the partnership.