Land To The Rear Of Astral House Astral Drive Thorpe Thewles Stockton-on-Tees TS21 3FJ

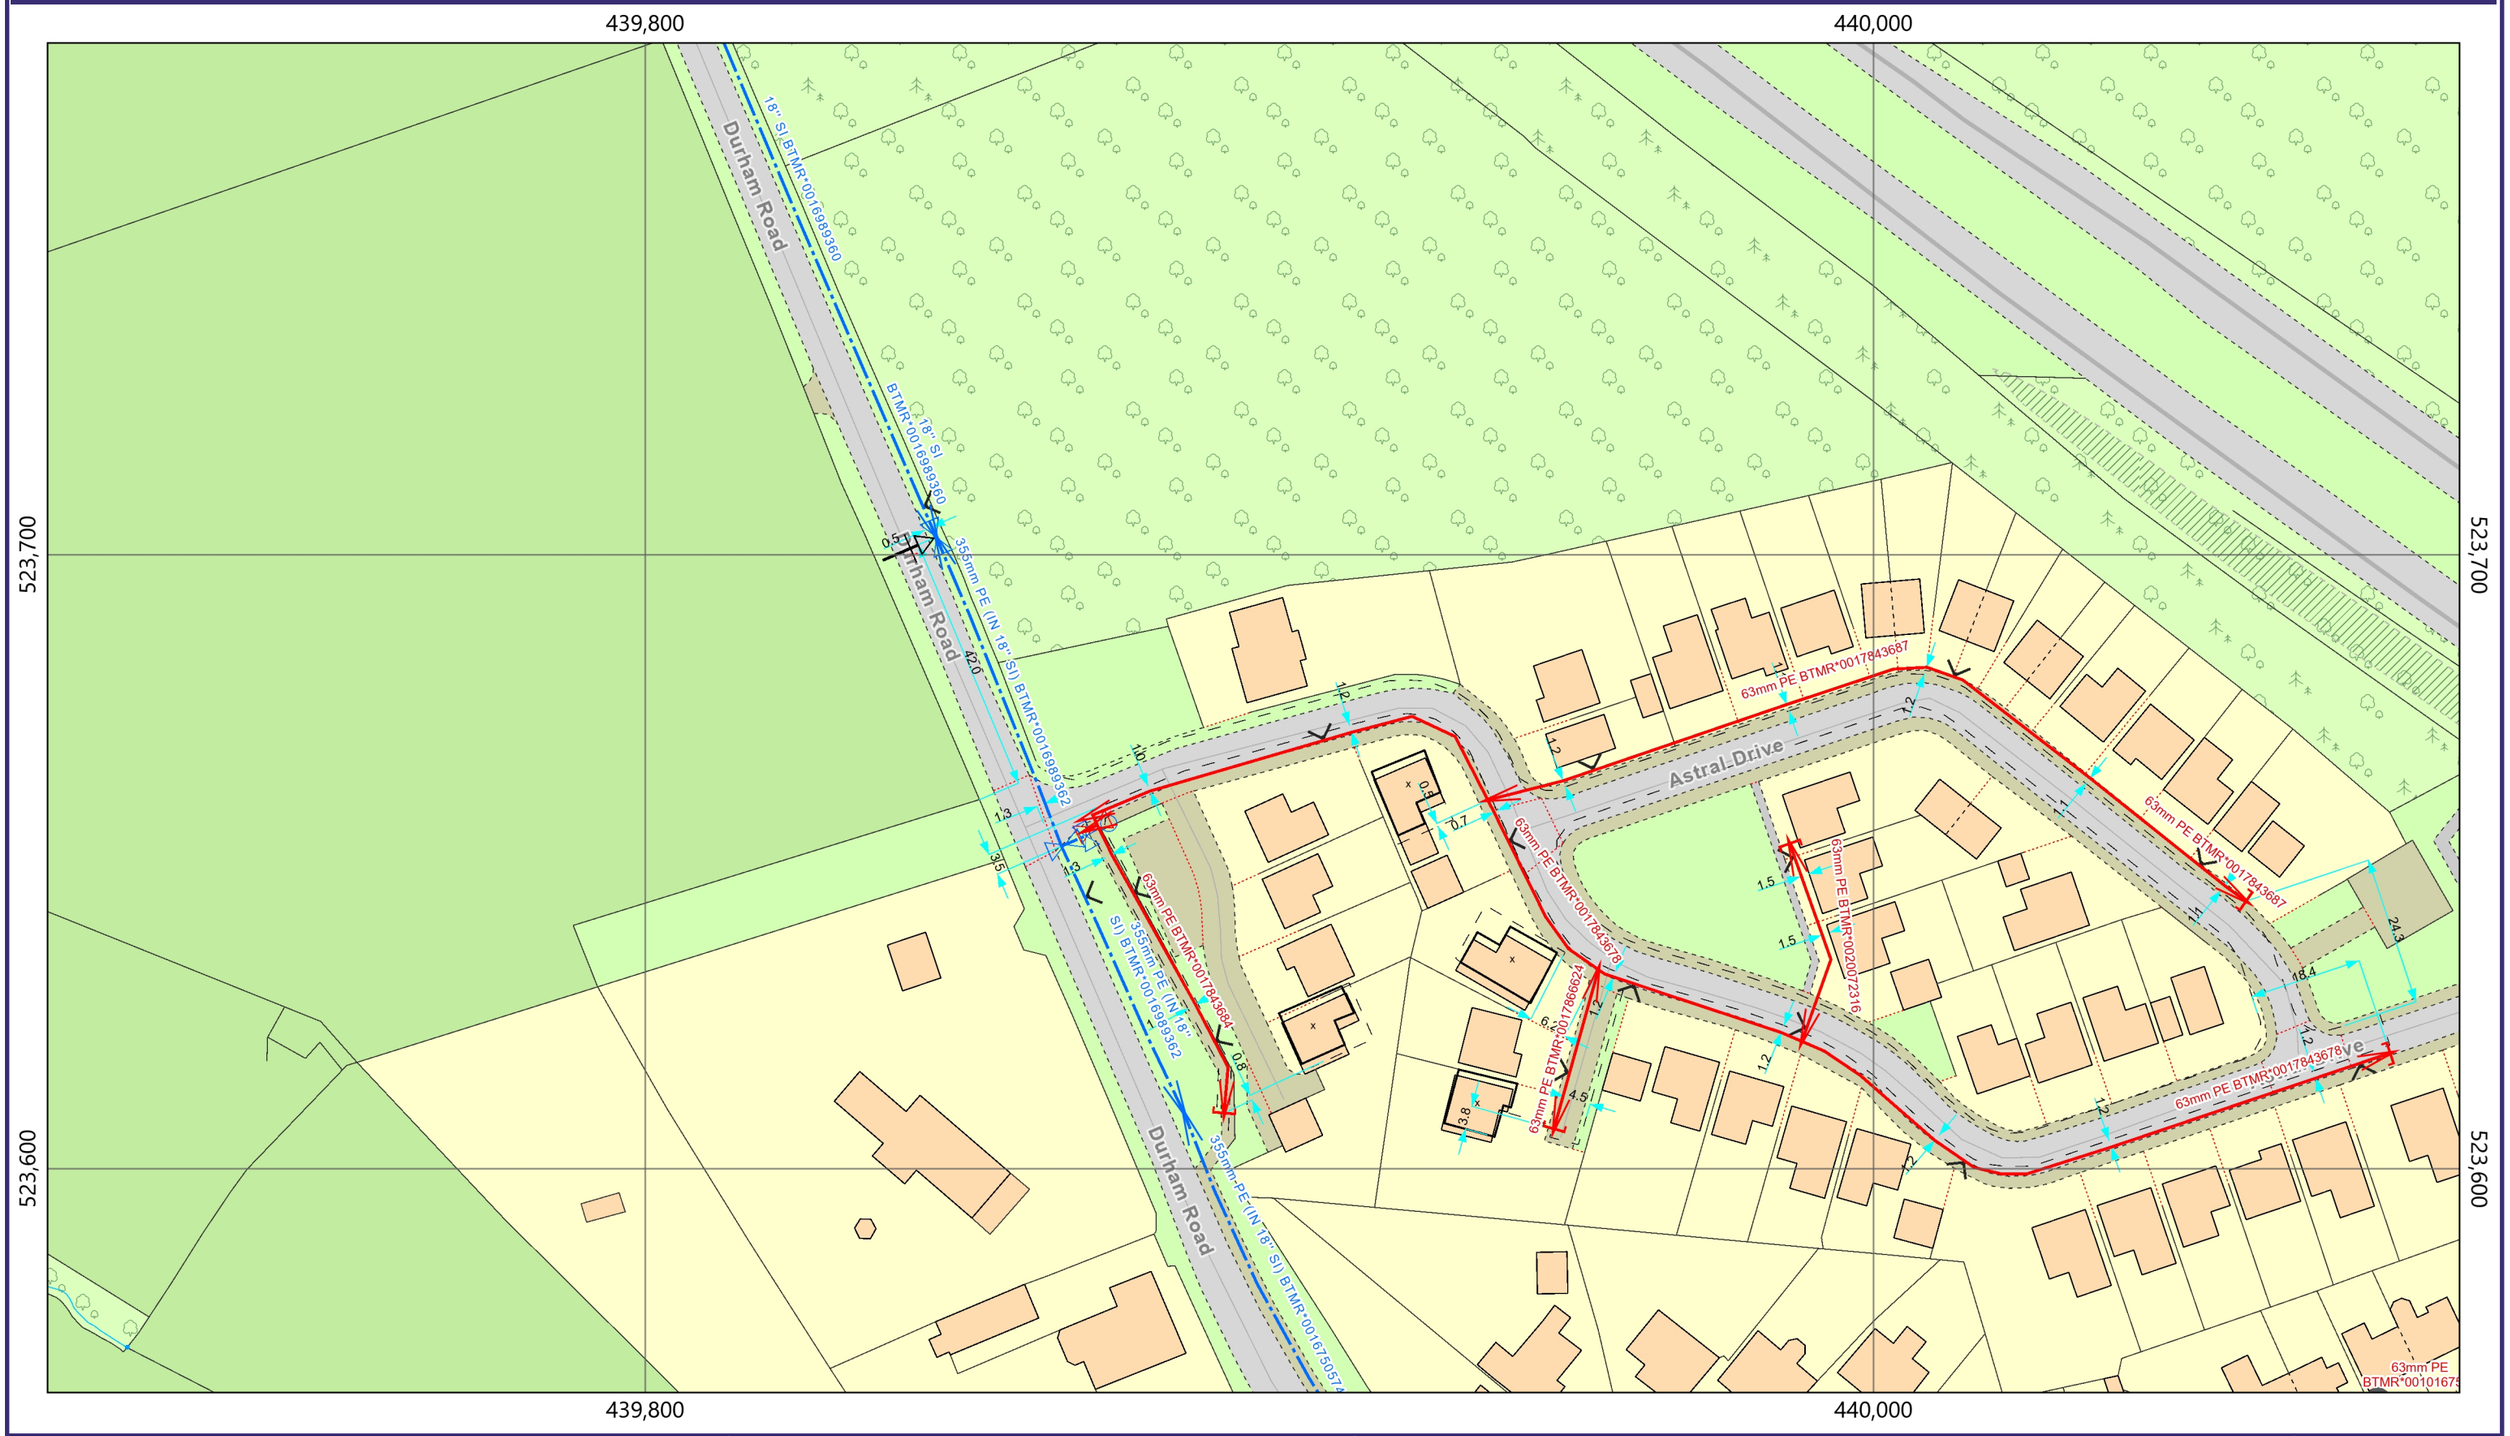

Legend

Pipe with Terminators
- Main/Service Pipe (IP)
- Main/Service Pipe (MP)
- Main/Service Pipe (LP)
- Transmission Pipe (LTS)
- Decommissioned Main/Service Pipe
- Decommissioned Transmission Pipe (LTS)

Pipe without Terminators
- Main/Service Pipe (IP)
- Main/Service Pipe (MP)
- Main/Service Pipe (LP)
- Transmission Pipe (LTS)
- Decommissioned Main/Service Pipe
- Decommissioned Transmission Pipe (LTS)

Gas Network Assembly
- District Governor (RH)
- District Governor (IP)
- District Governor (MP)
- District Governor (LP)
- District Governor
- Decommissioned District Governor

Gas Network Junction
- Main/Service Pipe Junction
- Decommissioned Main/ Service Pipe Junction
- End Closure (IP)
- End Closure (MP)
- End Closure (IP)
- Decommissioned End Closure
- Riser Pipe Junction
- IGT Offtake

Gas Network Device
- Flow Stop (MP)
- MEG Point (LP)
- Pressure Measurement (IP)
- Pressure Measurement (MP)
- Pressure Measurement (LP)
- Purge Point (IP)
- Purge Point (MP)
- Purge Point (LP)
- Site Inlet-Outlet (IP)
- Site Inlet-Outlet (MP)
- Site Inlet-Outlet (LP)
- Site Inlet-Outlet (LTS)
- Stand Pipe (IP)
- Stand Pipe (MP)
- Stand Pipe (LP)

- Syphon (IP)
- Syphon (MP)
- Syphon (LP)
- Test Point (MP)
- Test Point (LP)
- Valve (IP)
- Valve (MP)
- Valve (LP)
- Decommissioned Flow Stop
- Decommissioned MEG Point
- Decommissioned Pressure Measurement
- Decommissioned Purge Point
- Decommissioned Site Inlet-Outlet
- Decommissioned Stand Pipe
- Decommissioned Syphon
- Decommissioned Test Point
- Decommissioned Valve

Non-Network Asset
- Change in Diameter
- Change in Material
- Crossover Connection
- Depth of Cover

Asset Protection Layers
- Slabbing
- Sleeving
- Protection Boundary

Legacy Dimension Line
- Abandoned
- As-Built

- Scheduled Monument
- SSSI
- Network Analysis
- IGT Area
- NTS
- Contact Zone Area

Wayleaves
- Easements
- Properties

Electric
- Cross-Section - Calc Marker Locations
- Cross-Section - Confirmed Locations
- Underground Cables (132kV)
- Underground Cables (66kV)
- Underground Cables (33kV)
- Underground Cables (25kV)
- Underground Cables (20kV)
- Underground Cables (11kV)
- Underground Cables (6kV)
- Underground Cables (3kV)
- Underground LV Mains Cables
- Underground LV Service Cables
- Underground LV Service - Assumed Route Cables
- Underground LV Service - Logical Connection Cables
- Underground Auxiliary Cables

- Underground Left in Situ Cables (132kV)
- Underground Left in Situ Cables (66kV)
- Underground Left in Situ Cables (33kV)
- Underground Left in Situ HV Cables
- Overhead Left in Situ Cables (132kV)
- Overhead Left in Situ Cables (66kV)
- Overhead Left in Situ Cables (33kV)
- Overhead Left in Situ HV Cables
- Overhead Conductors (132kV)
- Overhead Conductors (66kV)
- Overhead Conductors (33kV)
- Overhead Conductors (25kV)
- Overhead Conductors (20kV)
- Overhead Conductors (11kV)
- Overhead Conductors (6kV)
- Overhead Conductors (3kV)
- Overhead LV Mains
- Overhead LV Service
- Overhead Auxiliary

1: 1,000

0 30

Meters

Disclaimer Information

This plan shows those pipes owned by Northern Gas Networks or the relevant Gas Distribution Network in their roles as Licensed Gas Transporters (GT). Gas pipes owned by other GTs, or otherwise privately owned, may be present in this area. Information with regard to such pipes should be obtained from the relevant owners. The information shown on this plan is given without warranty, the accuracy thereof cannot be guaranteed. Service pipes, valves, syphons, stub connections, etc. are not shown but their presence should be anticipated. No liability of any kind whatsoever is accepted by Northern Gas Networks, the relevant Gas Distribution Network, or their agents, servants or contractors for any error or omission. Safe digging practices, in accordance with HS(G)47, must be used to verify and establish the actual position of mains, pipes, services and other apparatus on site before any mechanical plant is used. It is your responsibility to ensure that this information is provided to all persons (either direct labour or contractors) working for you on or near gas apparatus. The information included on this plan should not be referred to beyond a period of 28 days from the date of issue.

This plan is reproduced or based on the OS map by Northern Gas Networks, with the sanction of the controller of HM Stationary Office. Crown Copyright Reserved.

User ID	Lucy McMahon
Date	12/03/2024
Grid Ref	439899 / 523673

Northern Gas Networks

Advanced Plot