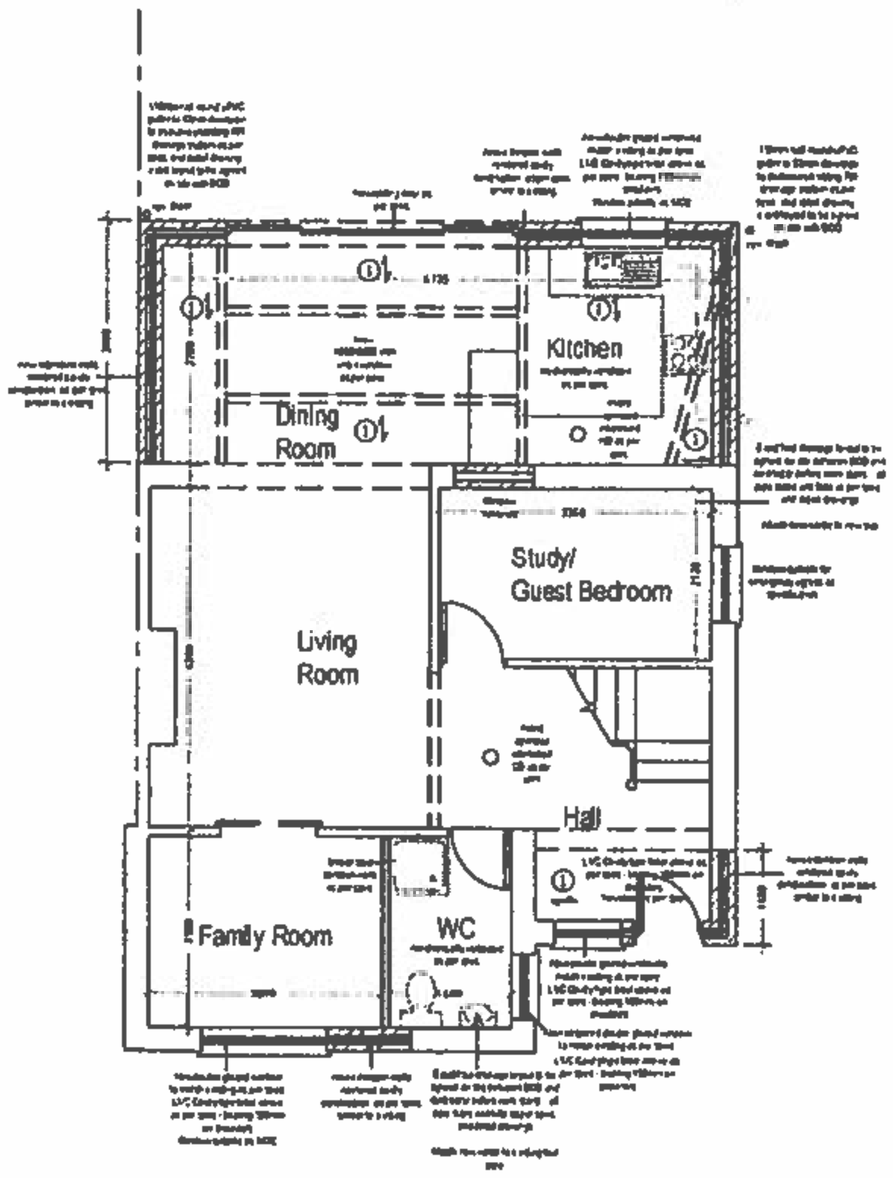


EXISTING
~~Proposed~~ Ground Floor Plan
Scale 1:50

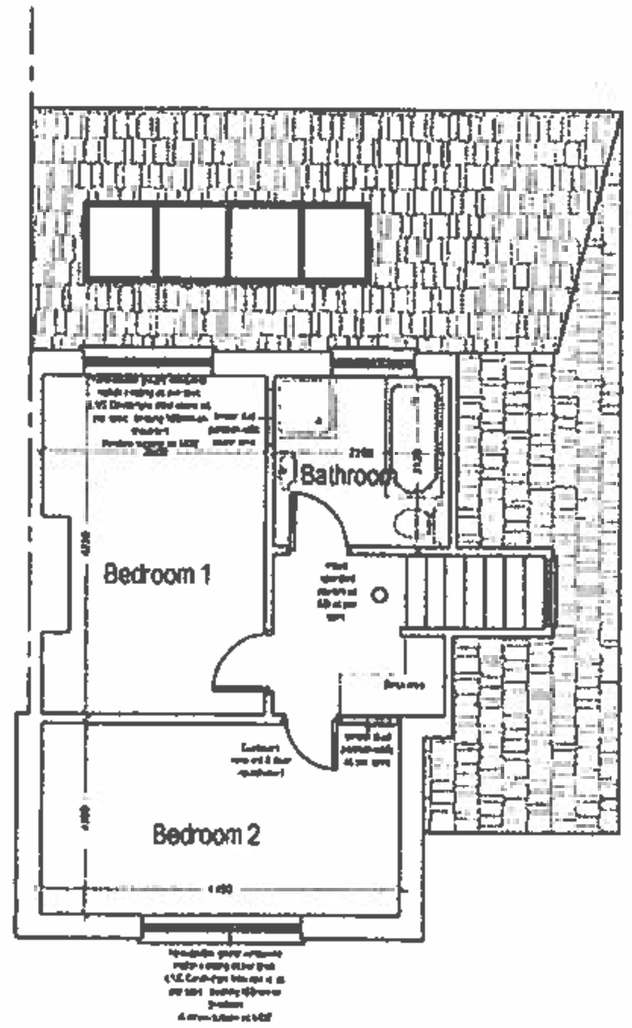


EXISTING
~~Proposed~~ First Floor Plan
Scale 1:50

| | | | |
|---|---|---|---|
| Arkiplan | 74 Cardiff Road, CF15 7QE<br>enquiries@ArkiPlan.co.uk | client:<br>55 Woodborough Road, Winscombe, Northsomerset BS251AG | job:<br>New Extension<br>Windows STAINED GLASS<br>date: 23/04/2020<br>scale: As Shown@A1 |
| | | | drawing title:<br>As Shown<br>drawing number:<br>19-0220 D03 |