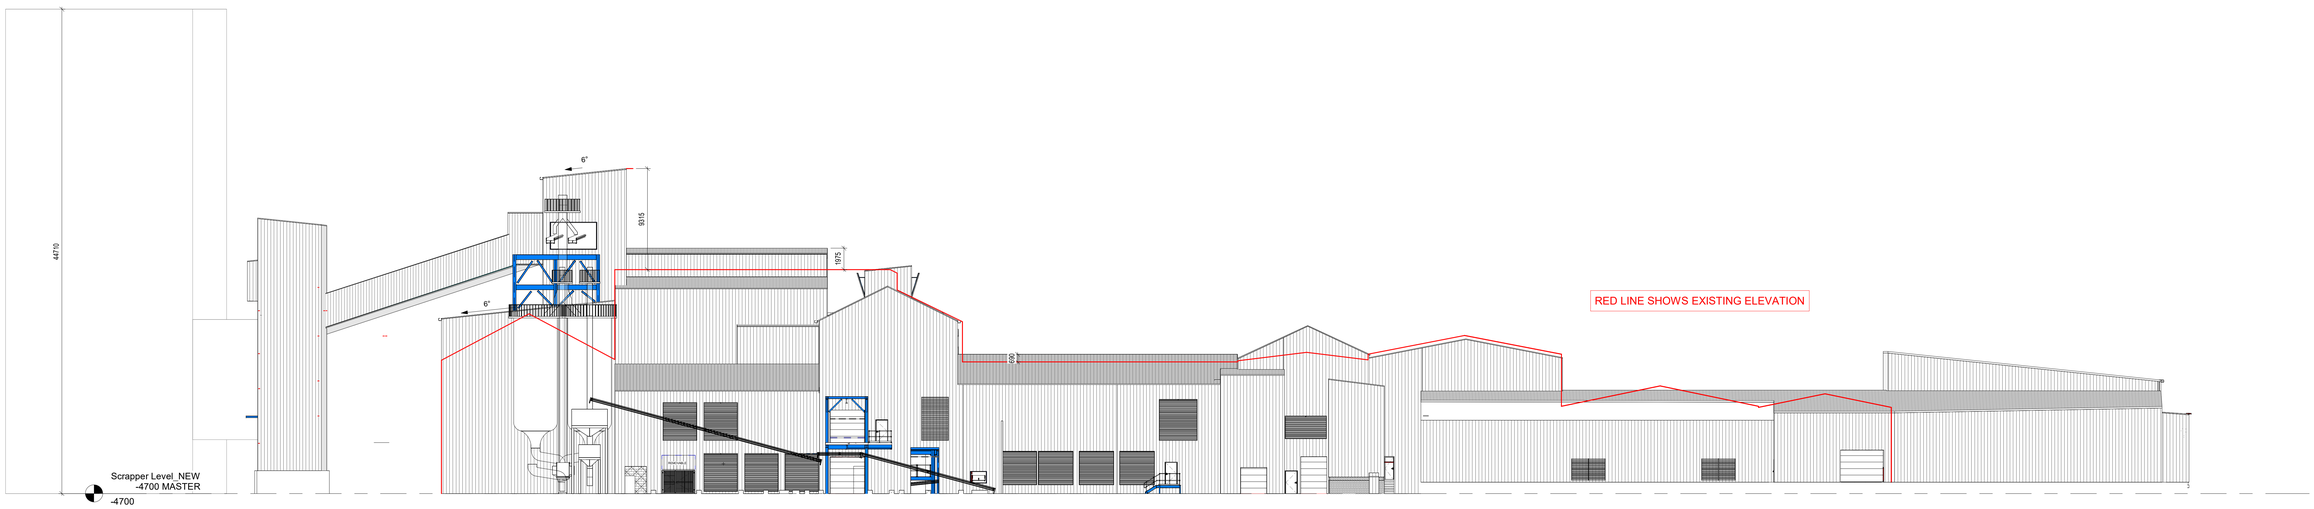

1 Elevation AA-P
1 : 200

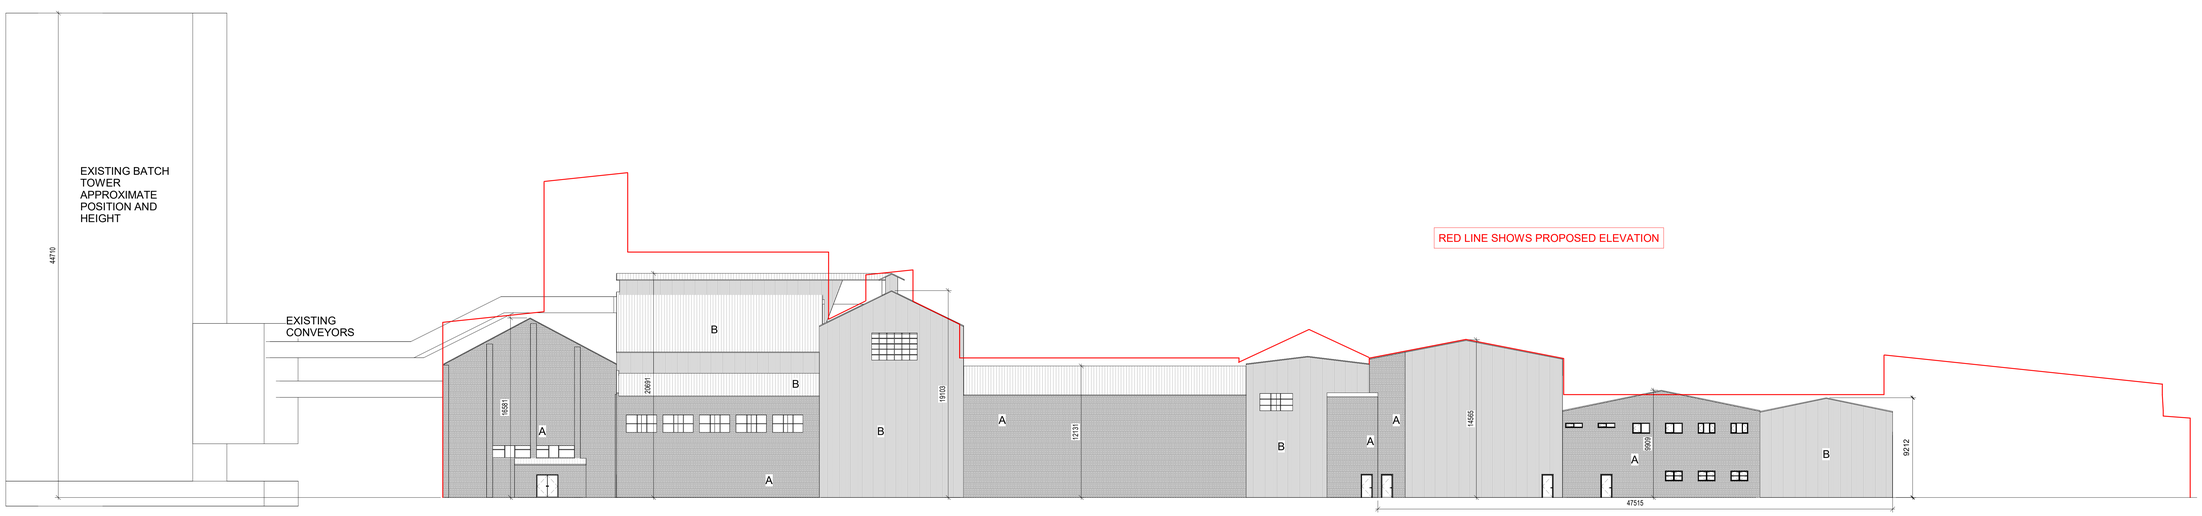

2 Elevation A Existing
1 : 200

1:200 0 5000 10000 15000 20000

1:1 0 10 20 30 40 50 60 70 80 90 100

Rev	Description	Date	Dr by	App by

Status: Planning

client: OI Manufacturing UK Ltd

location: Kellebank House, Glasshouse Loan, Alloa FK10 1NT

drawing: South Elevation proposed and existing with red line

date created: 11/09/23 | drawn by: Author | scale: 1 : 200 @A0 | approved by: Approver | revision date:

CHARLES SCOTT & PARTNERS CONSULTING ENGINEERS
Venlaw Building
349 Bath Street
Glasgow G2 4AA
Tel: 0141-331-2454
Fax: 0141-332-2875
www.cspvpd.co.uk

project reference: 9240 | drawing number: A300 | rev: